


MICROFILMED

FILED
GREENVILLE CO. S.C.
MAR 15 11 13 AM 1985
DONNIE S. TARKERSLEY
R.M.C.

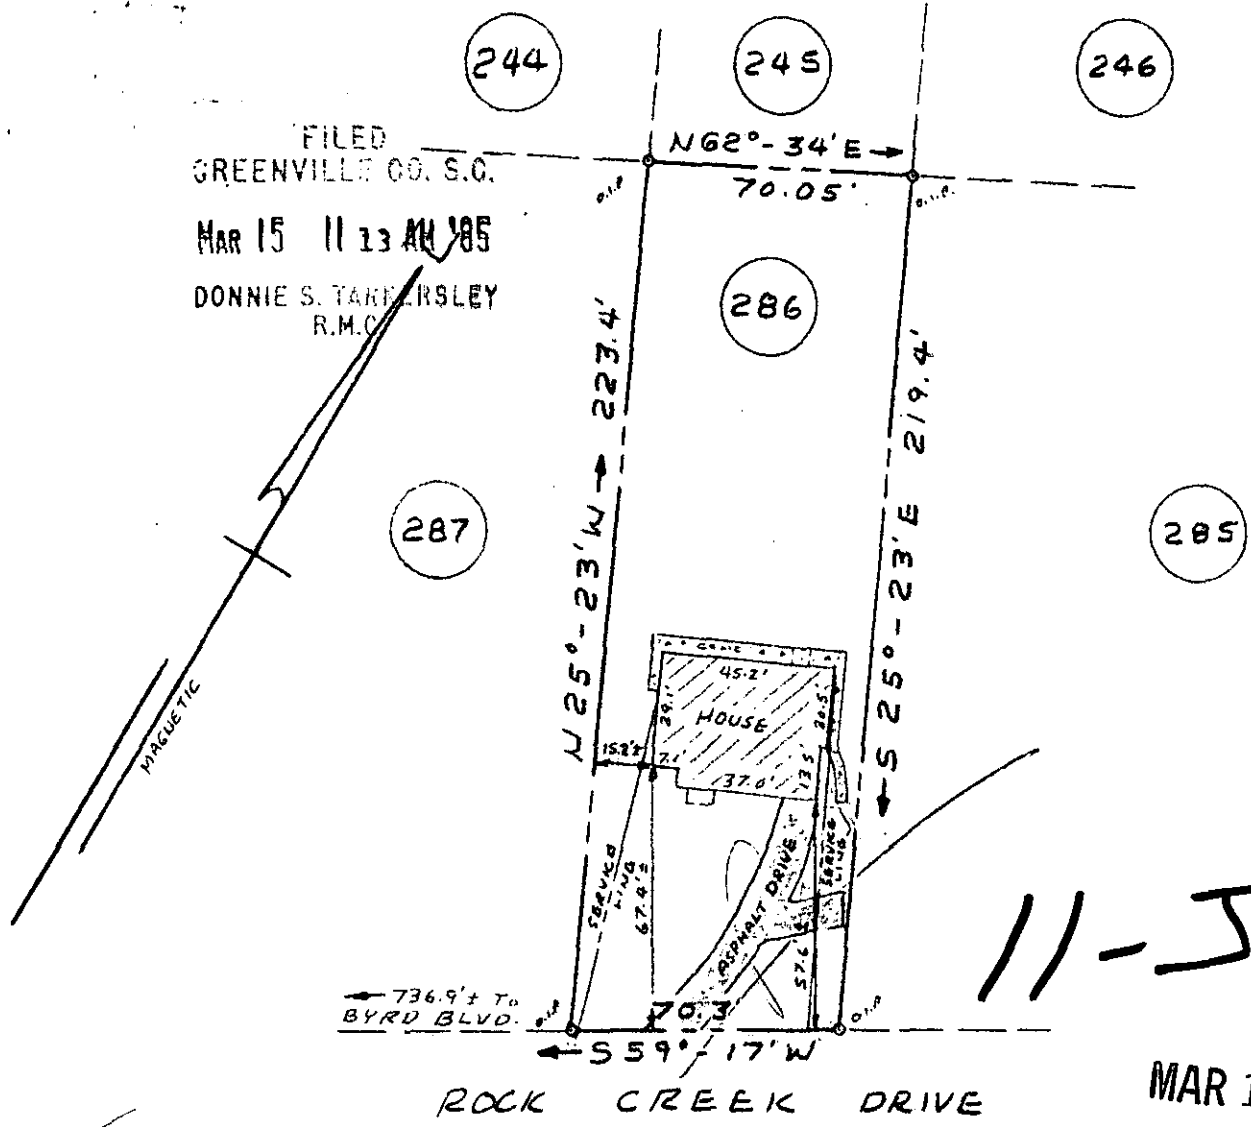

11-5-44

27195 ✓
MAR 15 1985

PROPERTY OF
SUSAN JANE WILLIAMS
 GREENVILLE, GREENVILLE COUNTY, S.C.
 MARCH 13, 1985 SCALE: 1" = 50'

This is to certify that on March 13, 1985, I surveyed the property shown on this plat known as Lot No. 286 of Second Revision of Traxler Park, as recorded in the RMC Office for Greenville County in Plat. Bk. G, Pages 115-116, and that the property lines, walls and buildings are as shown hereon, and that the building located on said lot does not project nor encroach on adjacent streets or property, and that no adjacent walls or buildings project nor encroach on said lot, and that no utility lines cross this lot except as may be shown hereon.

NOTE: This property is not located within a flood hazard area.

Survey by: Richard D. Wooten, Jr.
 Greenville, South Carolina

GCTC -- 3 MR15 85 1346 3.00CI