MICROFILMED

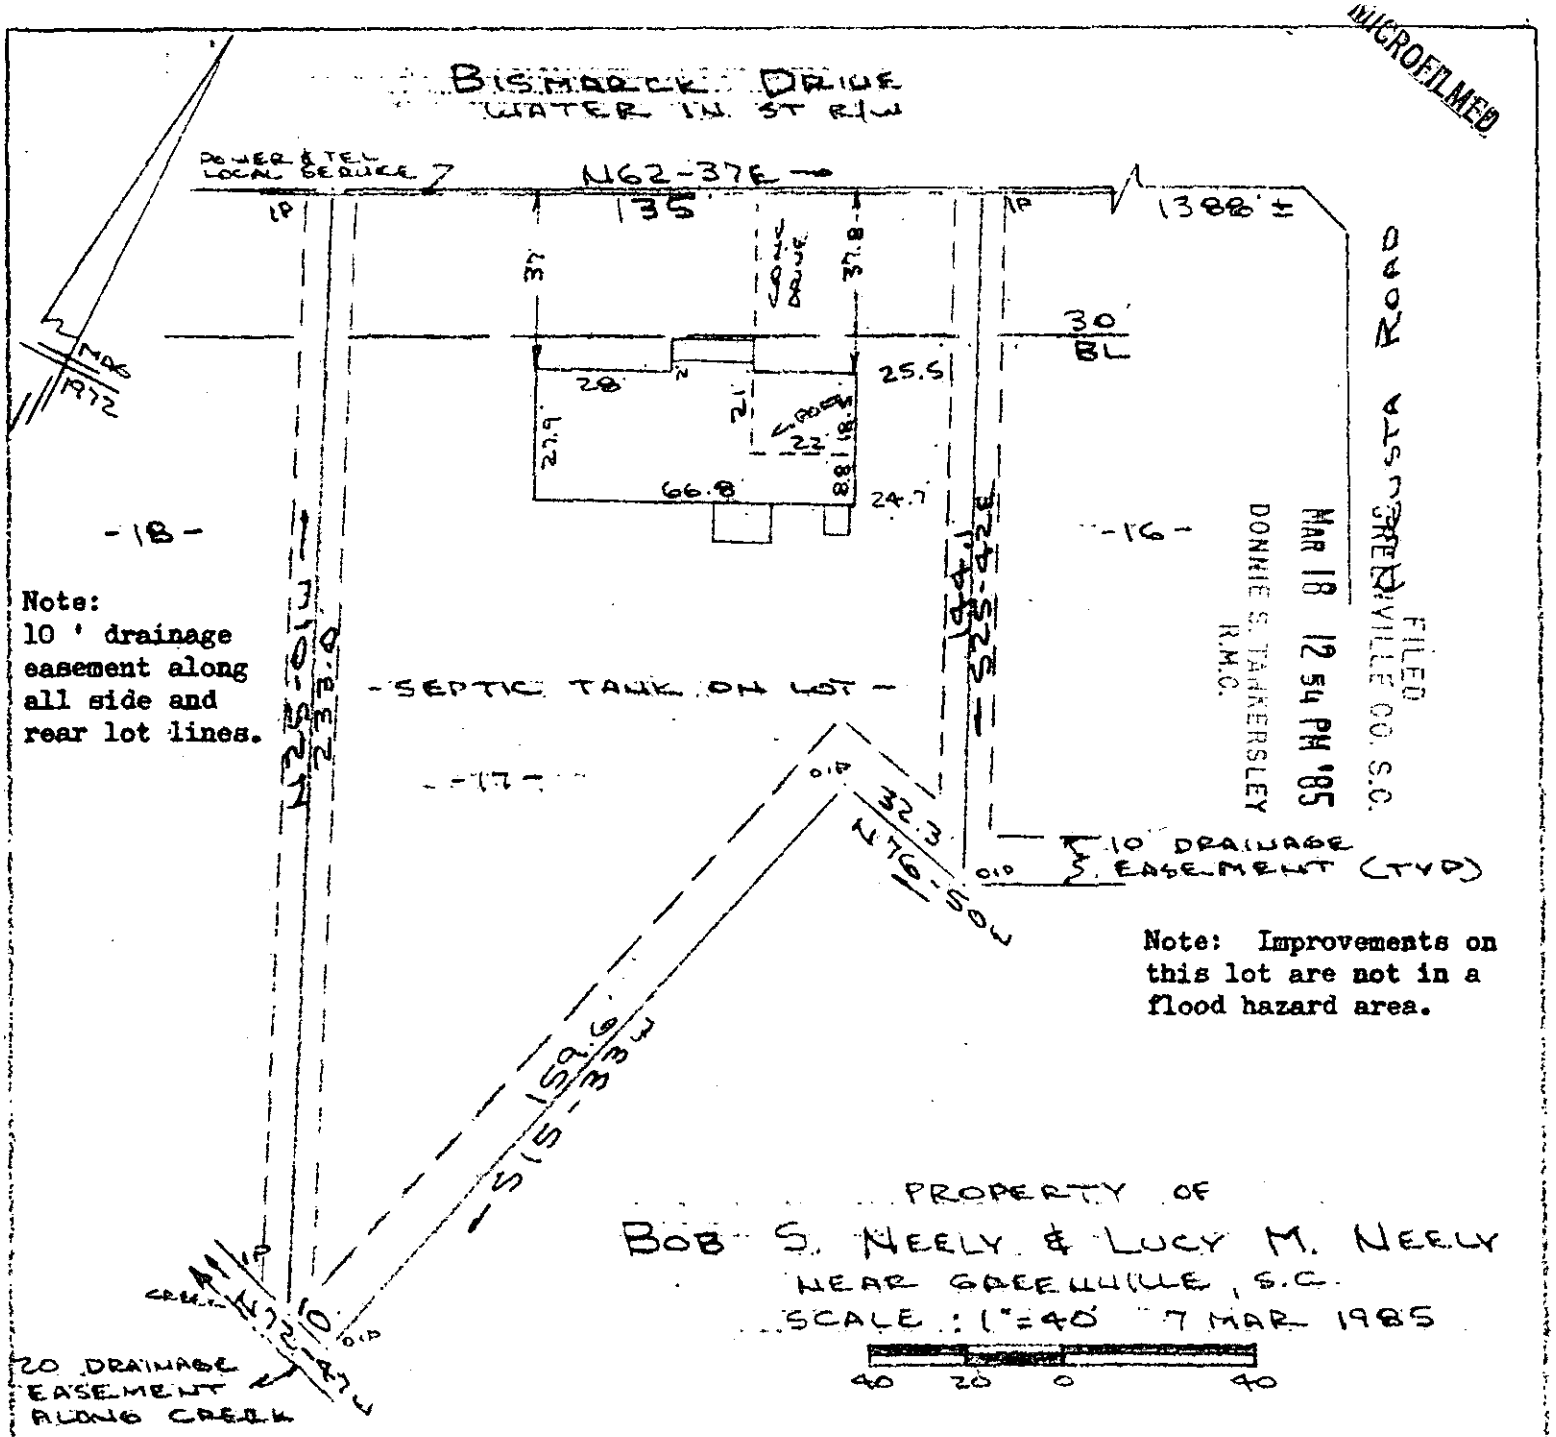

Note:
10 ' drainage easement along all side and rear lot lines.

Note: Improvements on this lot are not in a flood hazard area.

PROPERTY OF
BOB S. NEELY & LUCY M. NEELY
NEAR GREENVILLE, S.C.
SCALE: 1"=40' 7 MAR 1985

This is to certify that on the 7th day of March, 1985, I surveyed the property shown on this plat, being known as lot 17 on plat of DAKOTA HILLS SECTION 2 and recorded in the RMC Office Greenville County, S. C., in Plat Book " 5 - D " at Page 77; and that the property lines, walls and buildings are as shown hereon, and that the property lines, walls and buildings located on said lot do not encroach or project on adjacent street or property, and that no adjacent walls or buildings encroach or project on said premises, and no power lines cross this property except as shown hereon.

27361

11-J-58 MAR 18 1985

R. B. Bruce, RLS # 1952

CAROLINA SURVEYING CO.
112 Manly St.
Greenville, S. C.

Recordable Plat

300 3 31A01

289/2

603.1-1-23