


MICROFILMED

FILED
GREENVILLE CO. S.C.

MAR 18 3 11 PM '85

DONNIE S. TANKERSLEY
R.M.C.

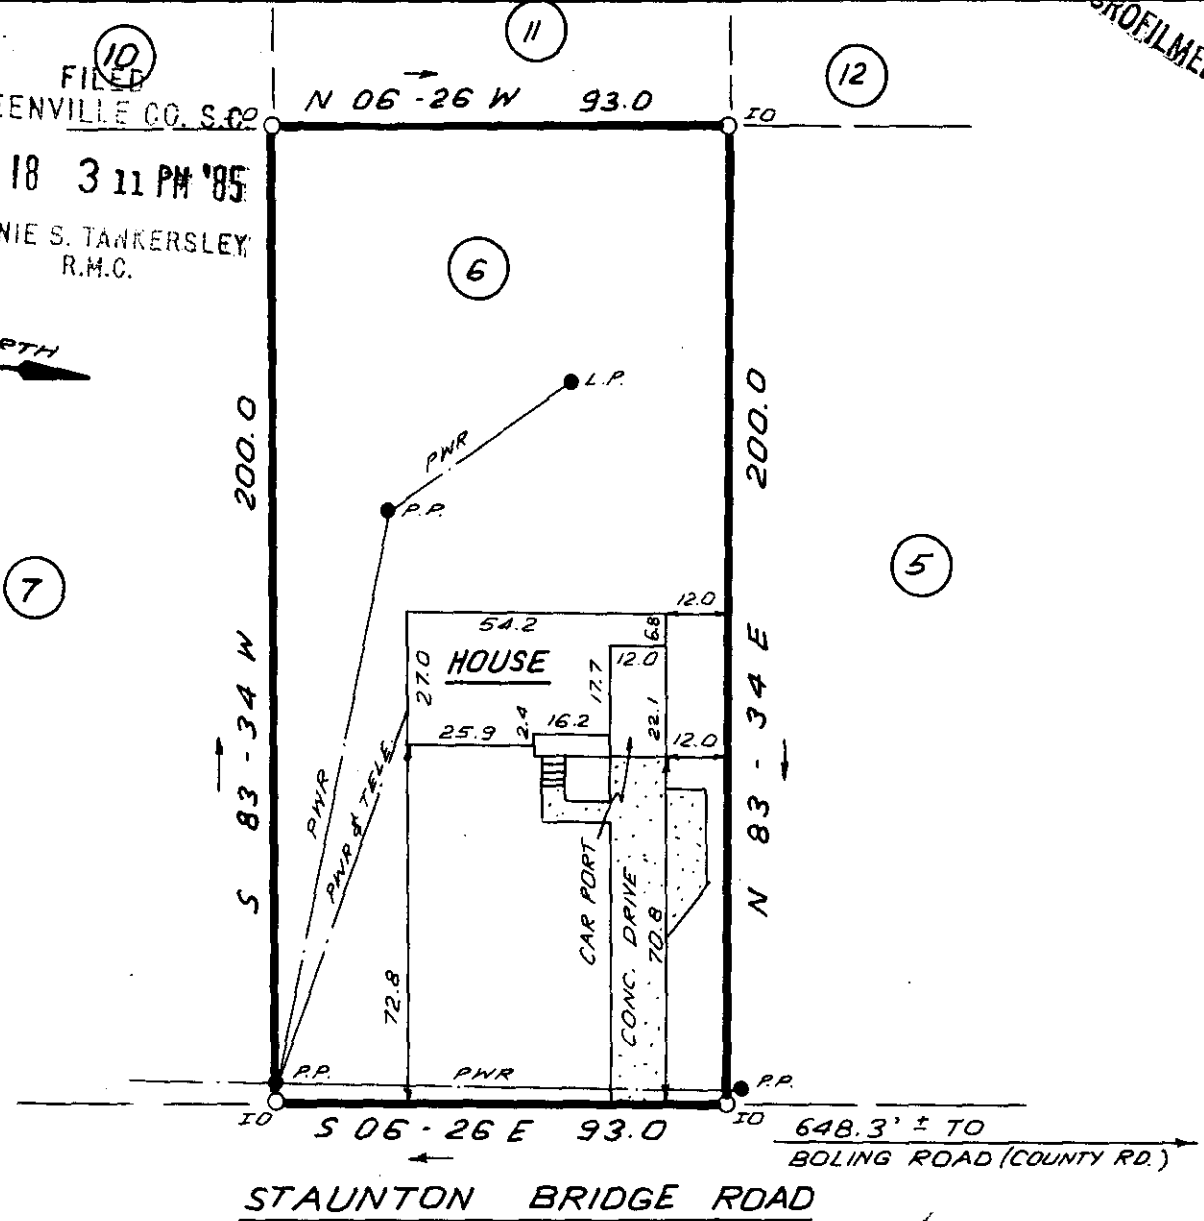

✓ 27356
 11 - I - 61
 MAR 18 1985

THIS IS TO CERTIFY THAT THE PROPERTY SHOWN ON THIS PLAT WAS SURVEYED UNDER MY DIRECT SUPERVISION PROPERTY LINES AND IMPROVEMENTS SHOWN ARE LOCATED CORRECTLY AND THAT NO VISIBLE ENCROACHMENTS EXIST UNLESS OTHERWISE SHOWN. THIS PROPERTY IS NOT LOCATED IN A DESIGNATED FLOOD HAZARD AREA

SOUTH CAROLINA REGISTERED LAND SURVEYOR
 4781
 JAMES R. FREELAND
 RLS JAMES R. FREELAND
 NO: 4781

STATE OF SOUTH CAROLINA GREENVILLE COUNTY

CHARLES L. TIDWELL PROP.
LOT 6
PROPERTY OF
MANUEL J. ANDERSON

FREELAND & ASSOCIATES
 Engineers • Land Surveyors
 318 WEST STONE AVENUE.
 GREENVILLE, S.C.
 (803) 271-4924

PLAT BOOK	40 - 130
DEED BOOK	1162 - 79
TAX MAP	253 - 1 - 16
PARTY CHIEF	M.L.C.
DRAWN	I.R.
DATE	11 - 13 - 84
DWG NO	12062

2 MRS 05 1125
 5.0001