
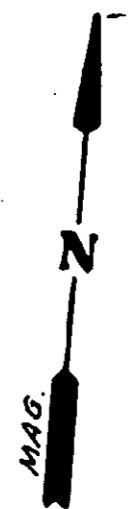


MICROFILMED

THE PRINT MACHINE, INC. N41289

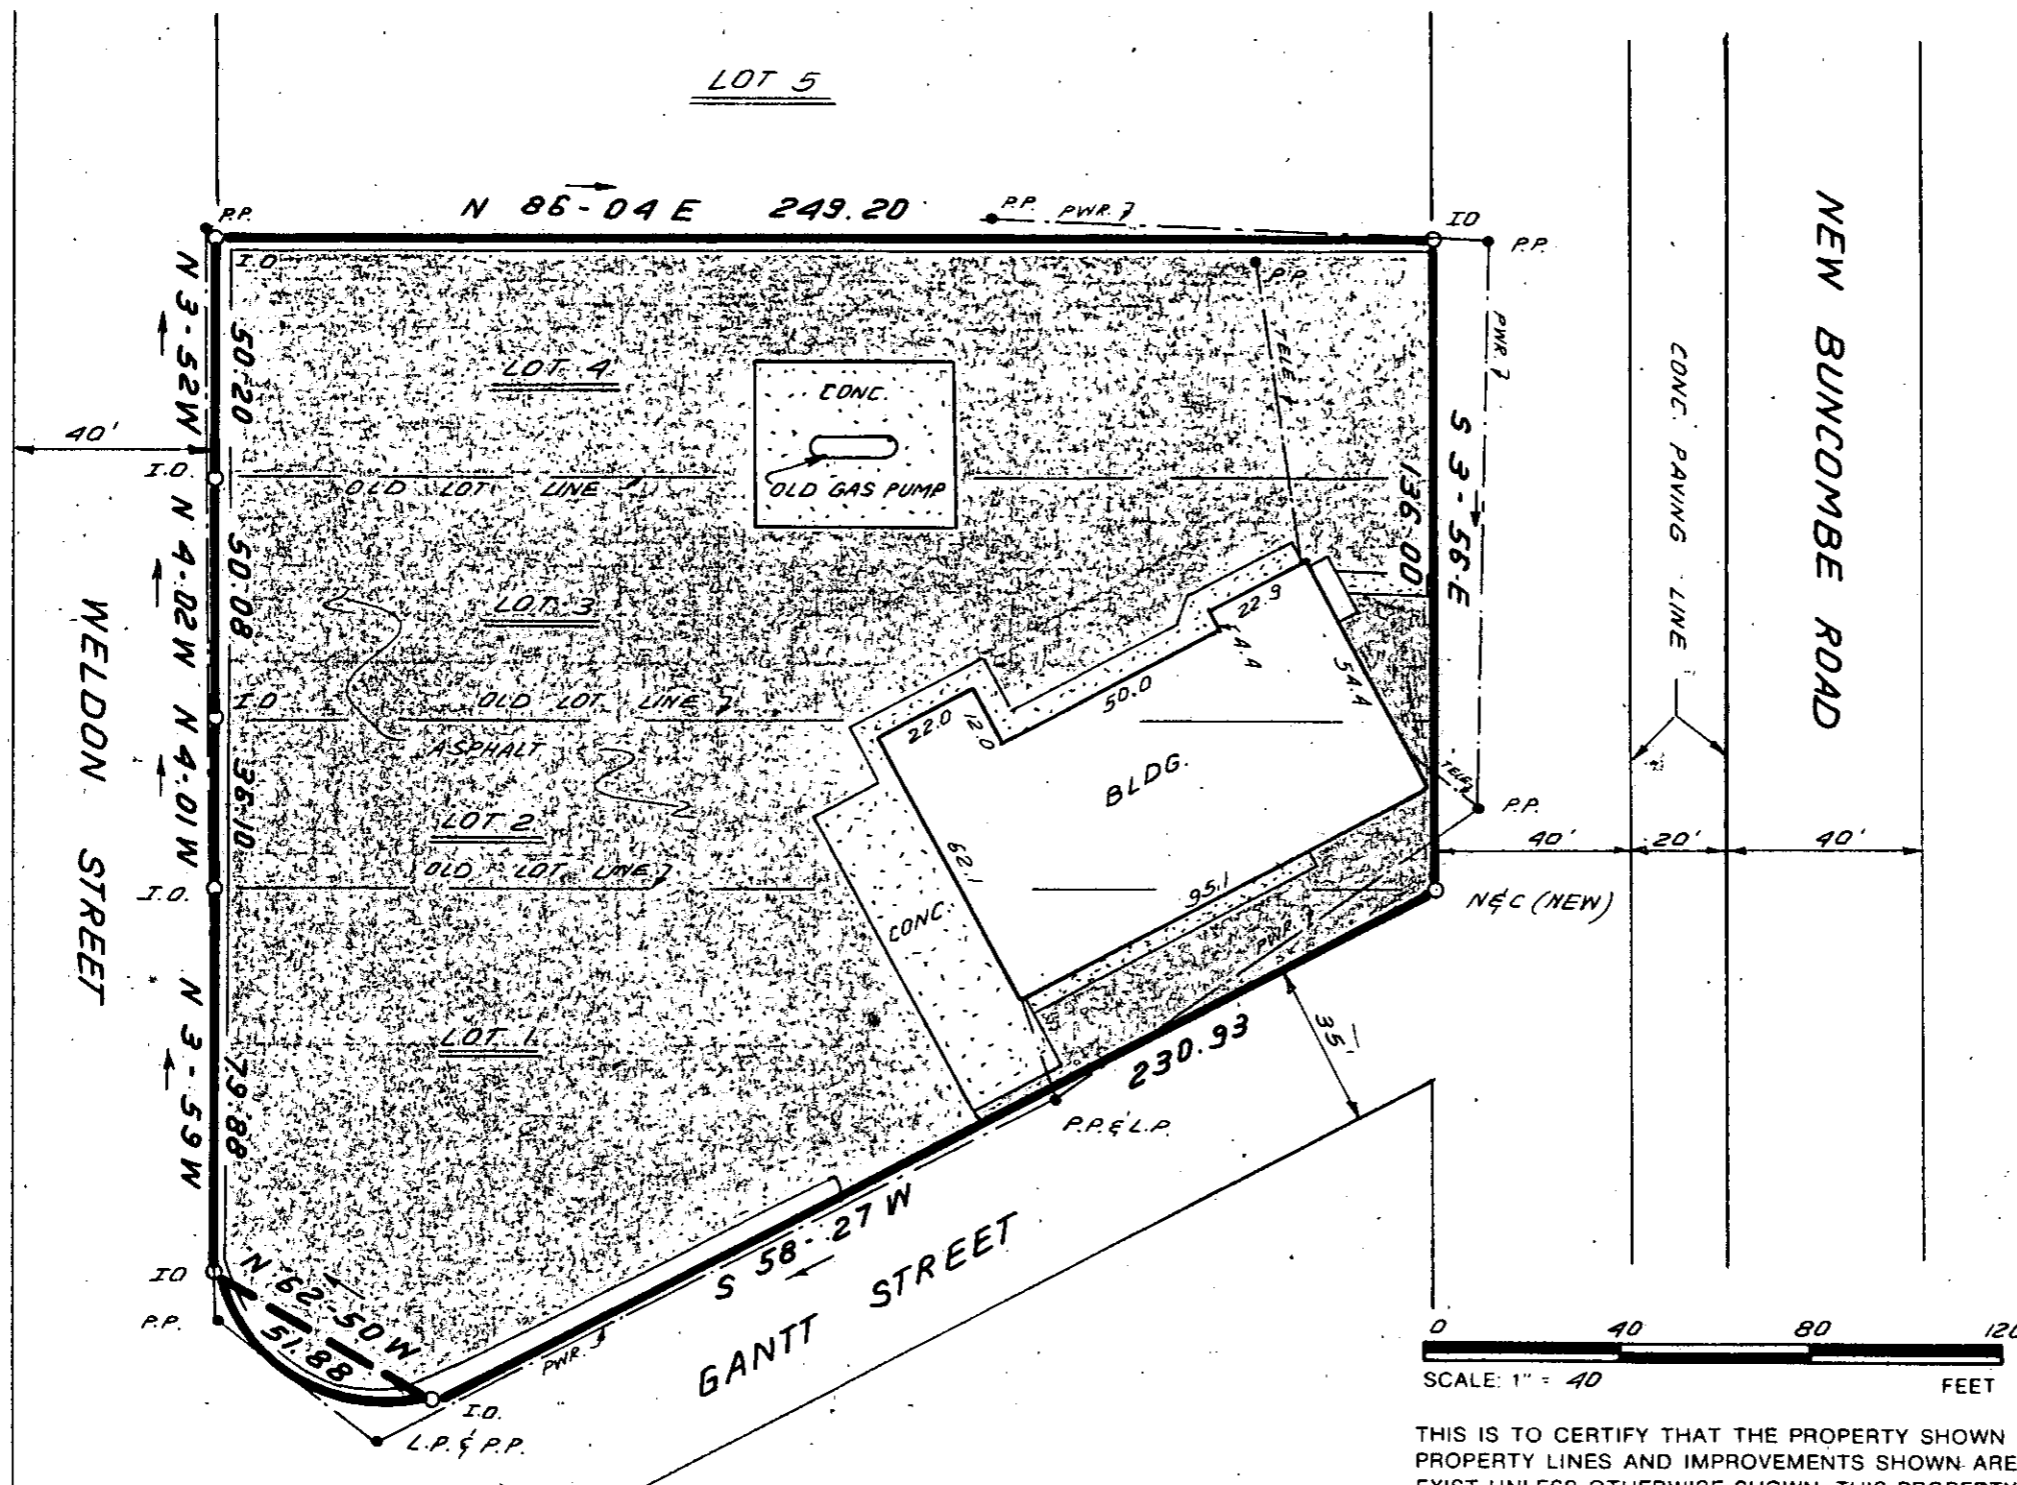

FILED
GREENVILLE CO. S.C.
APR 4 3 50 PM '85
DONNIE S. JAMBERSLEY
R.M.C.


29807

APR 4 1985

11-K-38

SCALE: 1" = 40 FEET

THIS IS TO CERTIFY THAT THE PROPERTY SHOWN ON THIS PLAT WAS SURVEYED UNDER MY DIRECT SUPERVISION. PROPERTY LINES AND IMPROVEMENTS SHOWN ARE LOCATED CORRECTLY AND THAT NO VISIBLE ENCROACHMENTS EXIST UNLESS OTHERWISE SHOWN. THIS PROPERTY IS NOT LOCATED IN A DESIGNATED FLOOD HAZARD AREA.

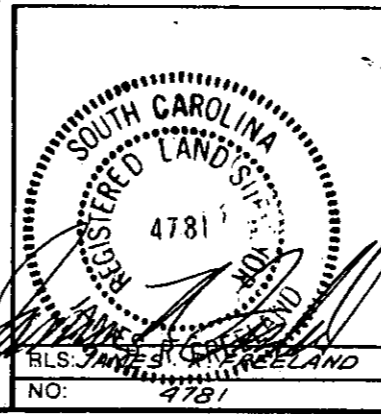

STATE OF SOUTH CAROLINA
GREENVILLE COUNTY

EDGAR C. WALDROP PROP.
LOT 1, 2, 3, 4
PROPERTY OF
SHIRLEY E. DUVALL

FREELAND & ASSOCIATES
Engineers • Land Surveyors
318 WEST STONE AVENUE.
GREENVILLE, S.C.
(803) 271-4924

PLAT BOOK	B - 171
DEED BOOK	820 - 513
TAX MAP	
PARTY CHIEF	JEC
DRAWN	B.R.
DATE	3-20-85
DWG. NO.	12,646