



MICROFILMED

CARL BLYTH

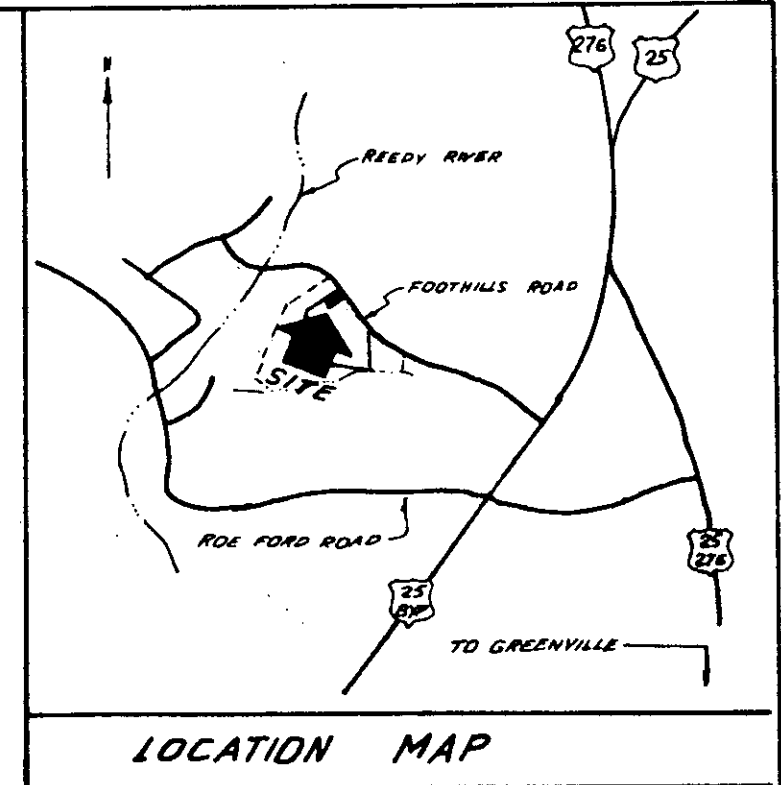


FILED  
 GREENVILLE CO. S.C.  
 APR 11 12 32 PM '85  
 DONNIE S. JANKERSLEY  
 R.M.C.

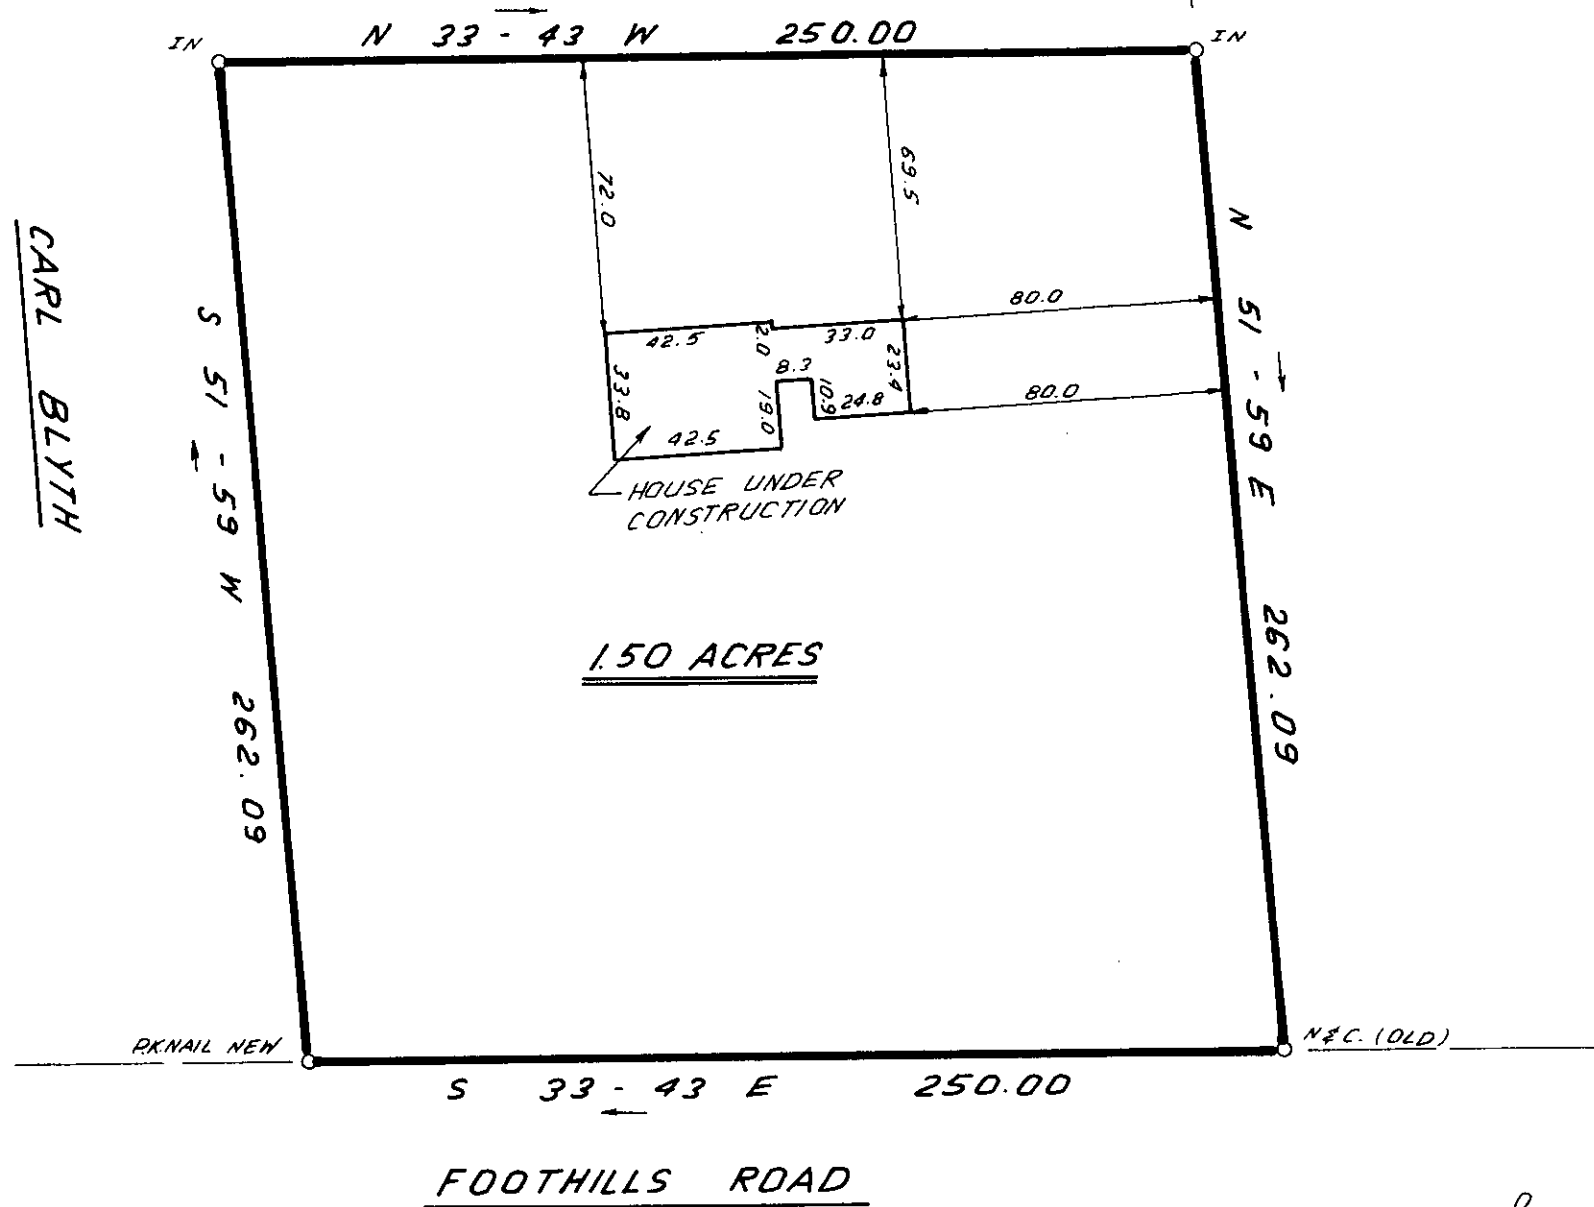

THIS IS TO CERTIFY THAT THE PROPERTY SHOWN ON THIS PLAT WAS SURVEYED UNDER MY DIRECT SUPERVISION. PROPERTY LINES AND IMPROVEMENTS SHOWN ARE LOCATED CORRECTLY AND THAT NO VISIBLE ENCROACHMENTS EXIST UNLESS OTHERWISE SHOWN. THIS PROPERTY IS NOT LOCATED IN A DESIGNATED FLOOD HAZARD AREA.

30558 ✓  
 11-K-47

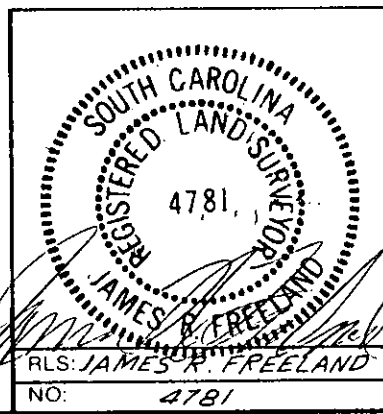

STATE OF SOUTH CAROLINA  
 GREENVILLE COUNTY

SURVEY FOR  
RON AYERS

FREELAND & ASSOCIATES  
 Engineers • Land Surveyors  
 318 WEST STONE AVENUE.  
 GREENVILLE, S.C.  
 (803) 271-4924

PLAT BOOK
DEED BOOK
TAX MAP
PARTY CHIEF R. J.
DRAWN I. P.
DATE 4-8-85
DWG. NO: 12769

THE PRINT MACHINE, INC. N41289