
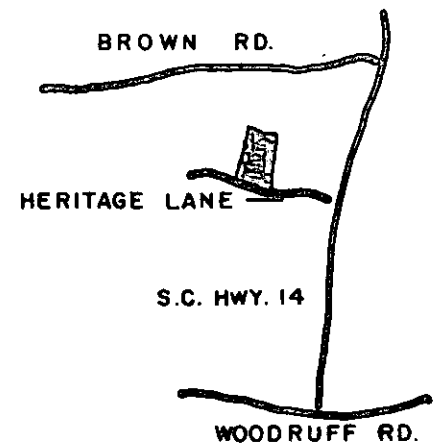


MICROFILMED

GC10 -----1 APR 11 1985 024

THE PRINT MACHINE, INC. 5.000.0

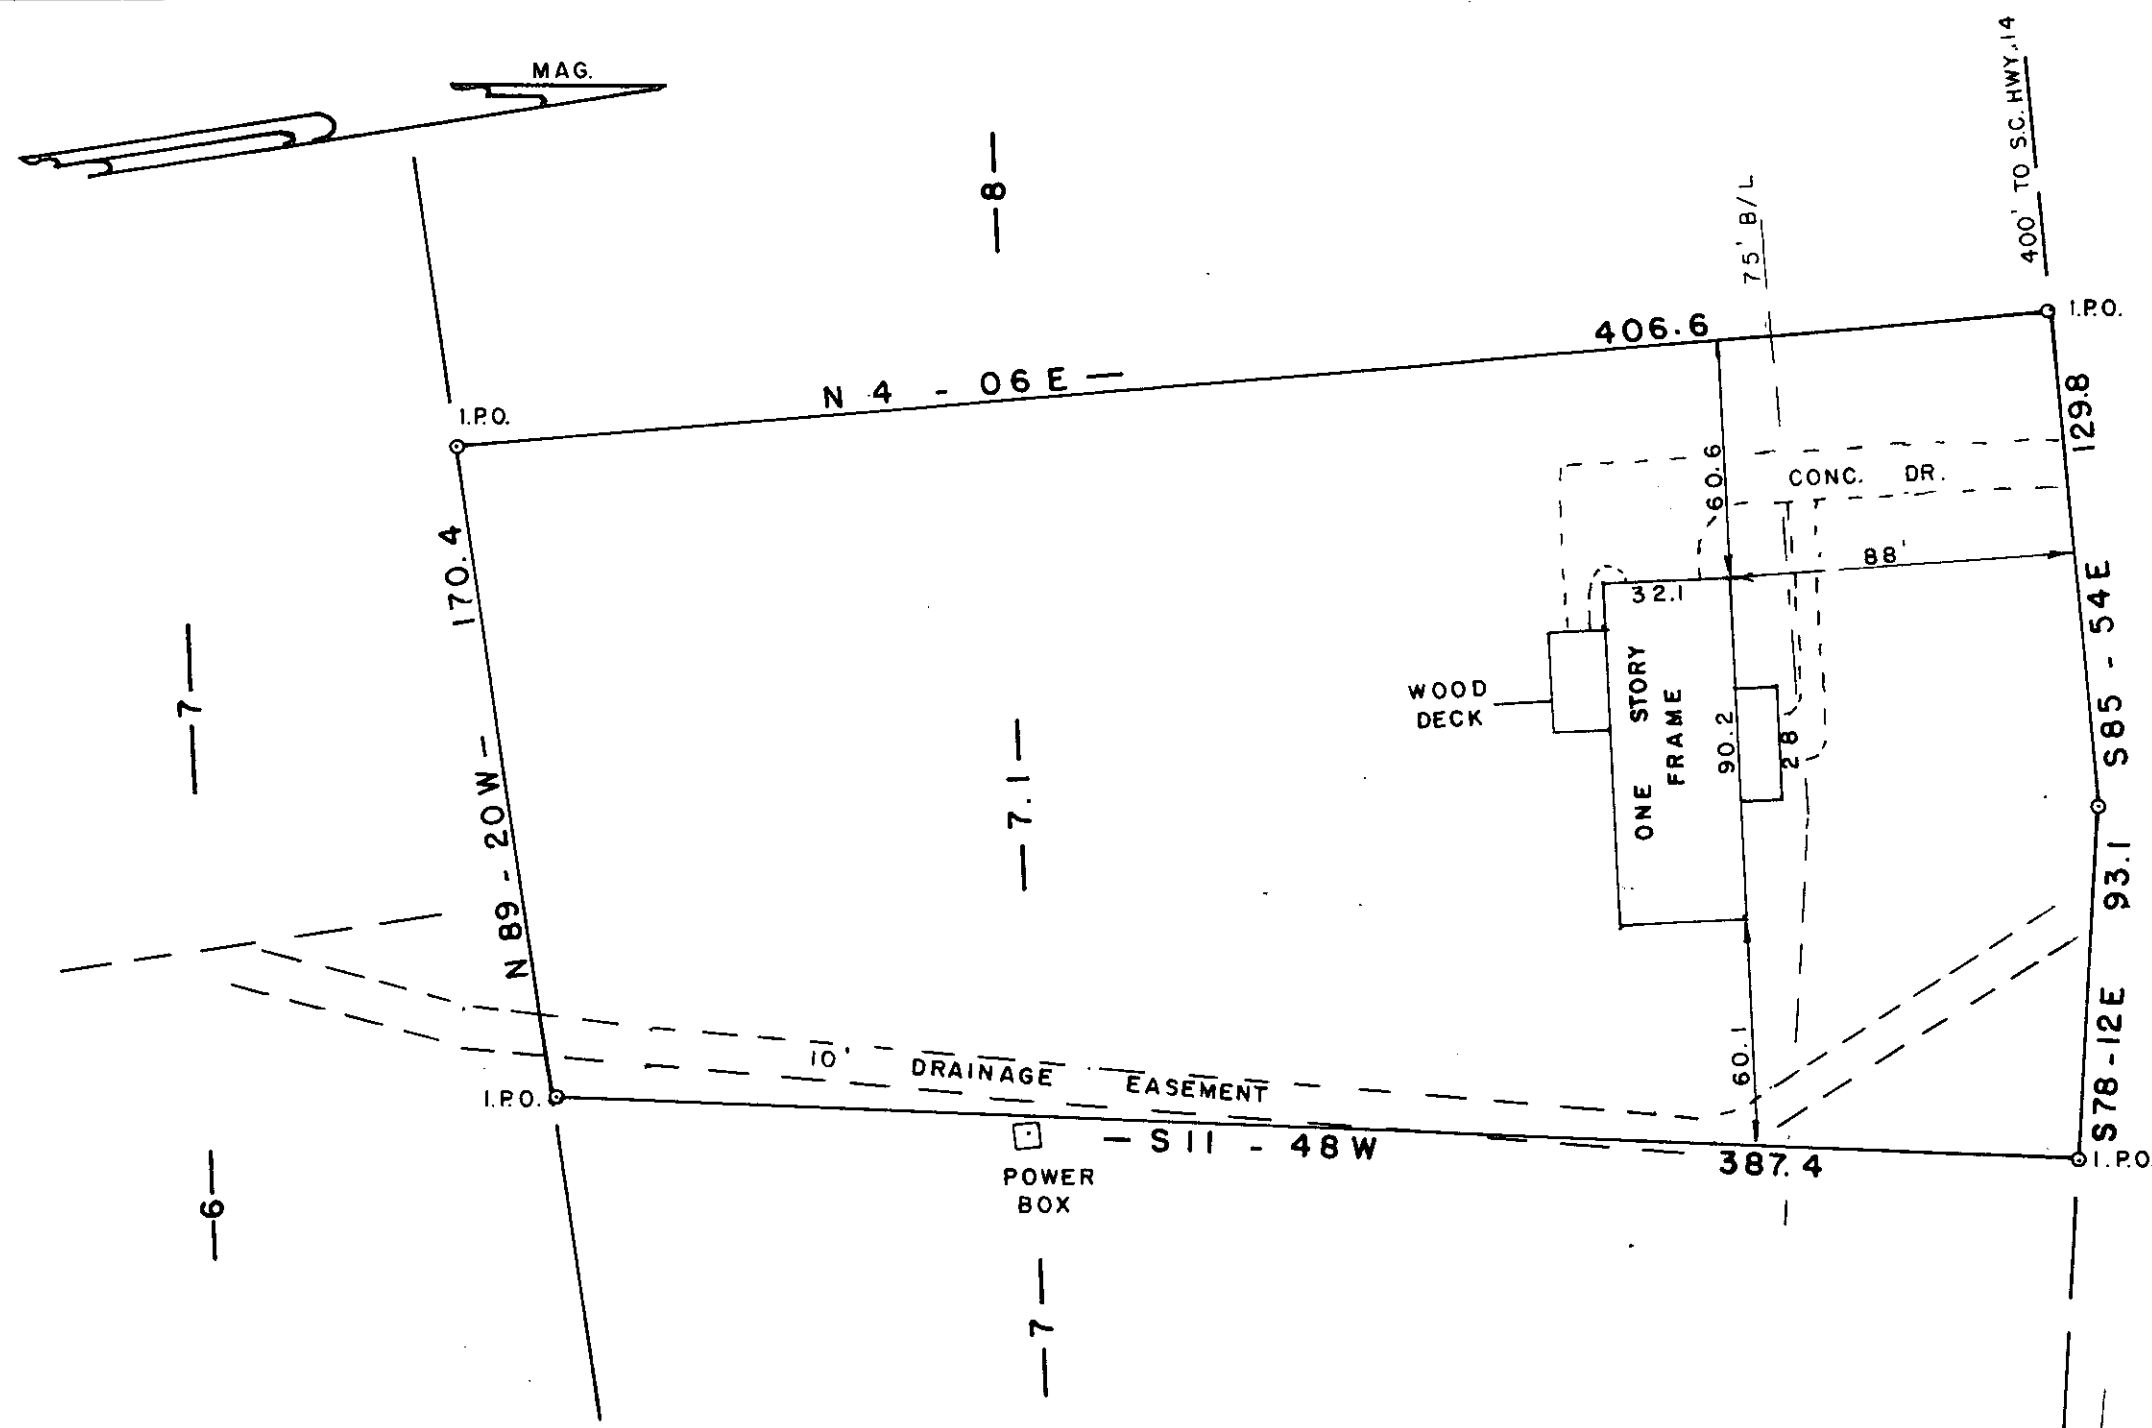

HERITAGE LANE


FILED
 GREENVILLE CO. S.C.
 APR 11 4 25 PM '85
 DONNIE S. JARRETSLEY
 R.M.C.

SURVEY FOR

HOLLAND REEVES

GREENVILLE CO. SOUTH CAROLINA

WEBB SURVEYING & MAPPING GROUP
 P.O. BOX 4756 - 29608

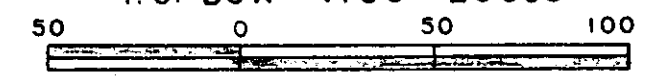

SCALE 1" = 50 FT.
 DATE APRIL 1985

CHARLES F. WEBB
 REGISTERED
 1577
 LAND SURVEYOR
 SOUTH CAROLINA

- I HEREBY CERTIFY THE RATIO OF PERECSON OF THE FIELD SURVEY IS 1/ 5000 THE AREA WAS DETERMINED BY D M D CALCULATION
- I HEREBY CERTIFY THAT THE PROPERTY LINES AND ANY IMPROVMENTS ARE CORRECT AND NO VISIBLE ENCROACHMENTS EXIST UNLESS OTHERWISE SHOWN
- THIS PROPERTY IS SUBJECT TO ANY EASEMENTS OR RIGHT OFWAYS OF RECORD OR NOT OF RECORD
- THIS PROPERTY IS NOT WITHIN A FLOOD HAZARD AREA

REF - PLAT BOOK 7X PAGE 52
 BLK. BK. REF. 539.6 - 1-7.1

11-K-49