




FILED  
GREENVILLE CO. S.C.  
MAR 27 4 27 PM '85  
DONNIE S. JAKKERSLEY  
R.M.C.

NAIL IN 12" SWEET GUM TREE

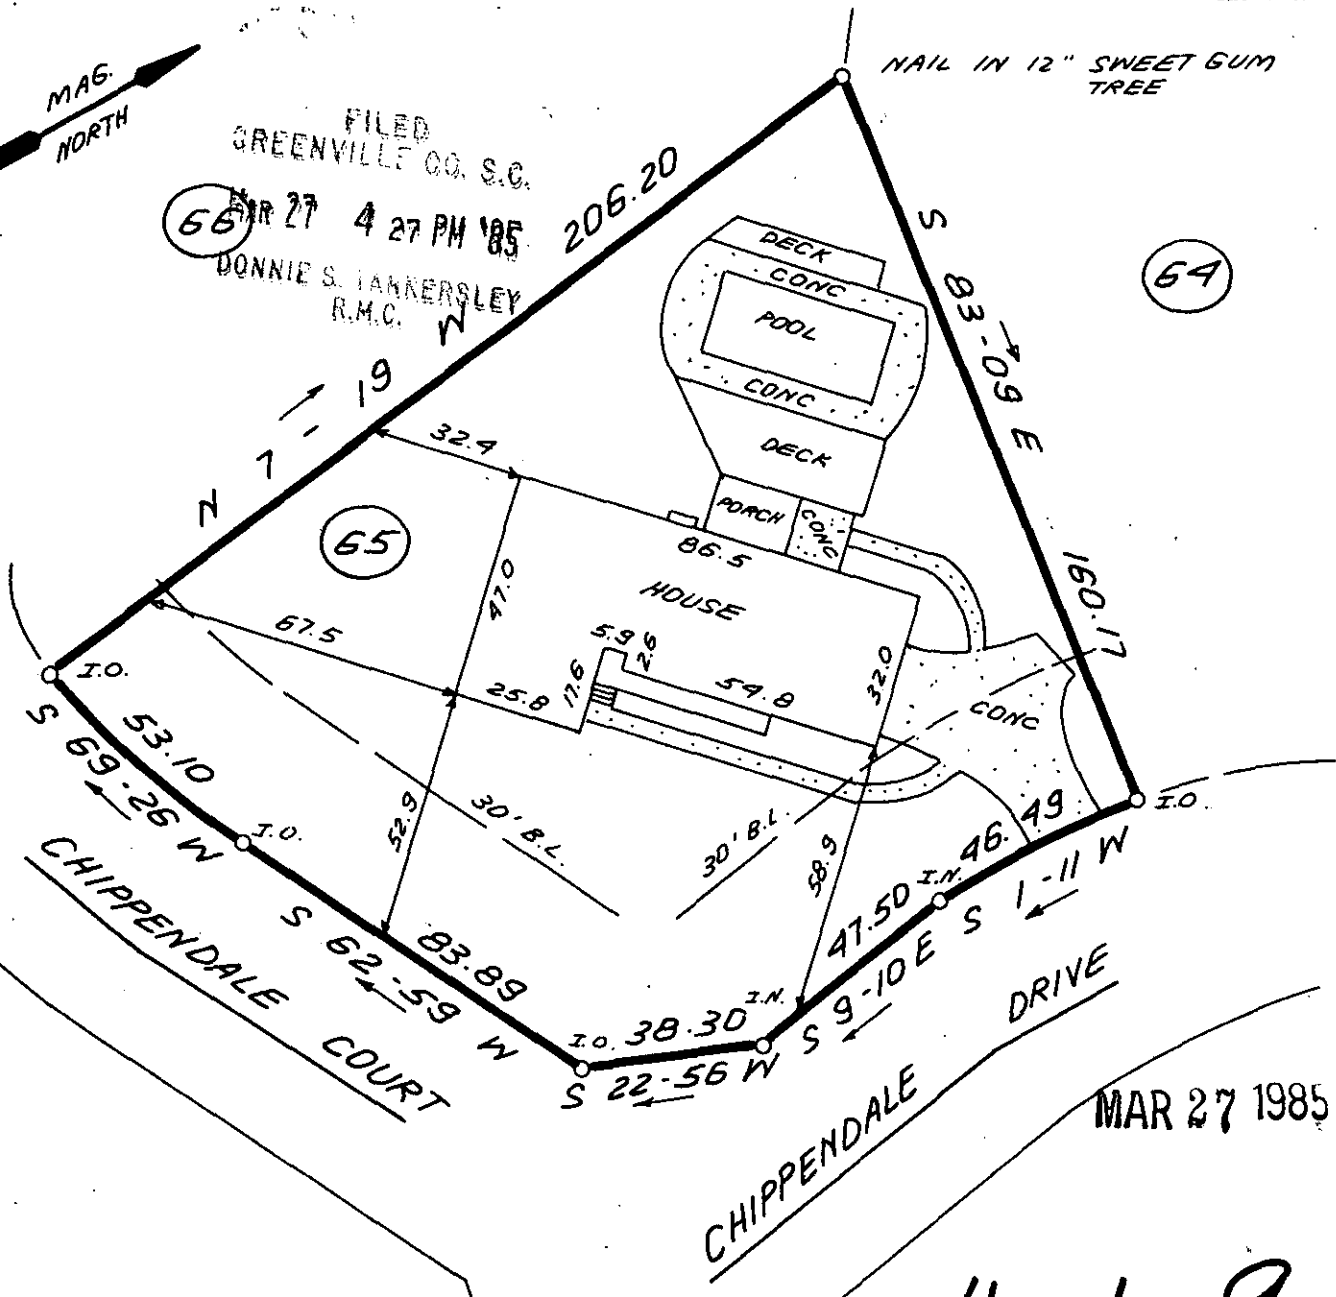

64

65

MAR 27 1985

11-L-9

28506

SCALE: 1" = 40' FEET

THIS IS TO CERTIFY THAT THE PROPERTY SHOWN ON THIS PLAT WAS SURVEYED UNDER MY DIRECT SUPERVISION. PROPERTY LINES AND IMPROVEMENTS SHOWN ARE LOCATED CORRECTLY AND THAT NO VISIBLE ENCROACHMENTS EXIST UNLESS OTHERWISE SHOWN. THIS PROPERTY IS NOT LOCATED IN A DESIGNATED FLOOD HAZARD AREA.

STATE OF SOUTH CAROLINA  
GREENVILLE COUNTY

FREELAND & ASSOCIATES  
Engineers • Land Surveyors  
318 WEST STONE AVENUE.  
GREENVILLE, S.C.  
(803) 271-4924

FOXCROFT  
MAP 1, SEC. 2, LOT 65  
PROPERTY OF  
THEDDRE A. MAIER  
RUTH D. MAIER

|             |            |
|-------------|------------|
| PLAT BOOK   | 4N @ 36    |
| DEED BOOK   |            |
| TAX MAP     | 590.9-1-65 |
| PARTY CHIEF | J.E.C.     |
| DRAWN       | K.E.G.     |
| DATE        | 3-26-85    |
| DWG. NO.    | 12577      |

SOUTH CAROLINA  
REGISTERED LAND SURVEYOR  
4781  
JAMES R. FREELAND

RLS: JAMES R. FREELAND  
NO: 4781