

Aster Drive
 FILED
 GREENVILLE CO. S.C.
 APR 1 11 02 AM '85
 DONNIE S. THAKERSLEY
 R.M.C.

PROPERTY OF
SAM W. JR. & REBECCA A. AVERY
 GREENVILLE CO. SIMPSONVILLE, S. C.


Scale 1" = 40' March 28, 1985

This is to certify that on the 28th day of March, 1985, I surveyed the property shown on this plat, being known as Lot 149 on plat of "POINSETTIA SEC. NO. 3" and recorded in the Greenville Co. R.M.C. Office in Plat Book PFP at Page 141, and that the property lines, walls and buildings are as shown hereon, and that the walls and buildings located on said lot do not encroach or project onto adjacent streets or property and that no adjacent walls or buildings encroach or project on said premises, and that no utility lines cross this property except as shown. This property is located above the flood hazard area.

11-6-32

APR 1 1985
 29069 ✓

T.H. Walker Jr.
 T.H. Walker Jr., Reg. L.S. No. 3182
 300 Maple Drive
 Mauldin, South Carolina 29662

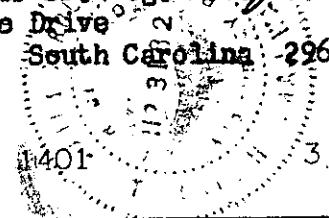

GOTO -- 3 APR. 1 85 1401 3.0001