


MICROFILMED

FILED  
GREENVILLE CO. S.C.  
APR 1 11 31 AM '85  
DONNIE S. TANNERSLEY  
R.M.C.

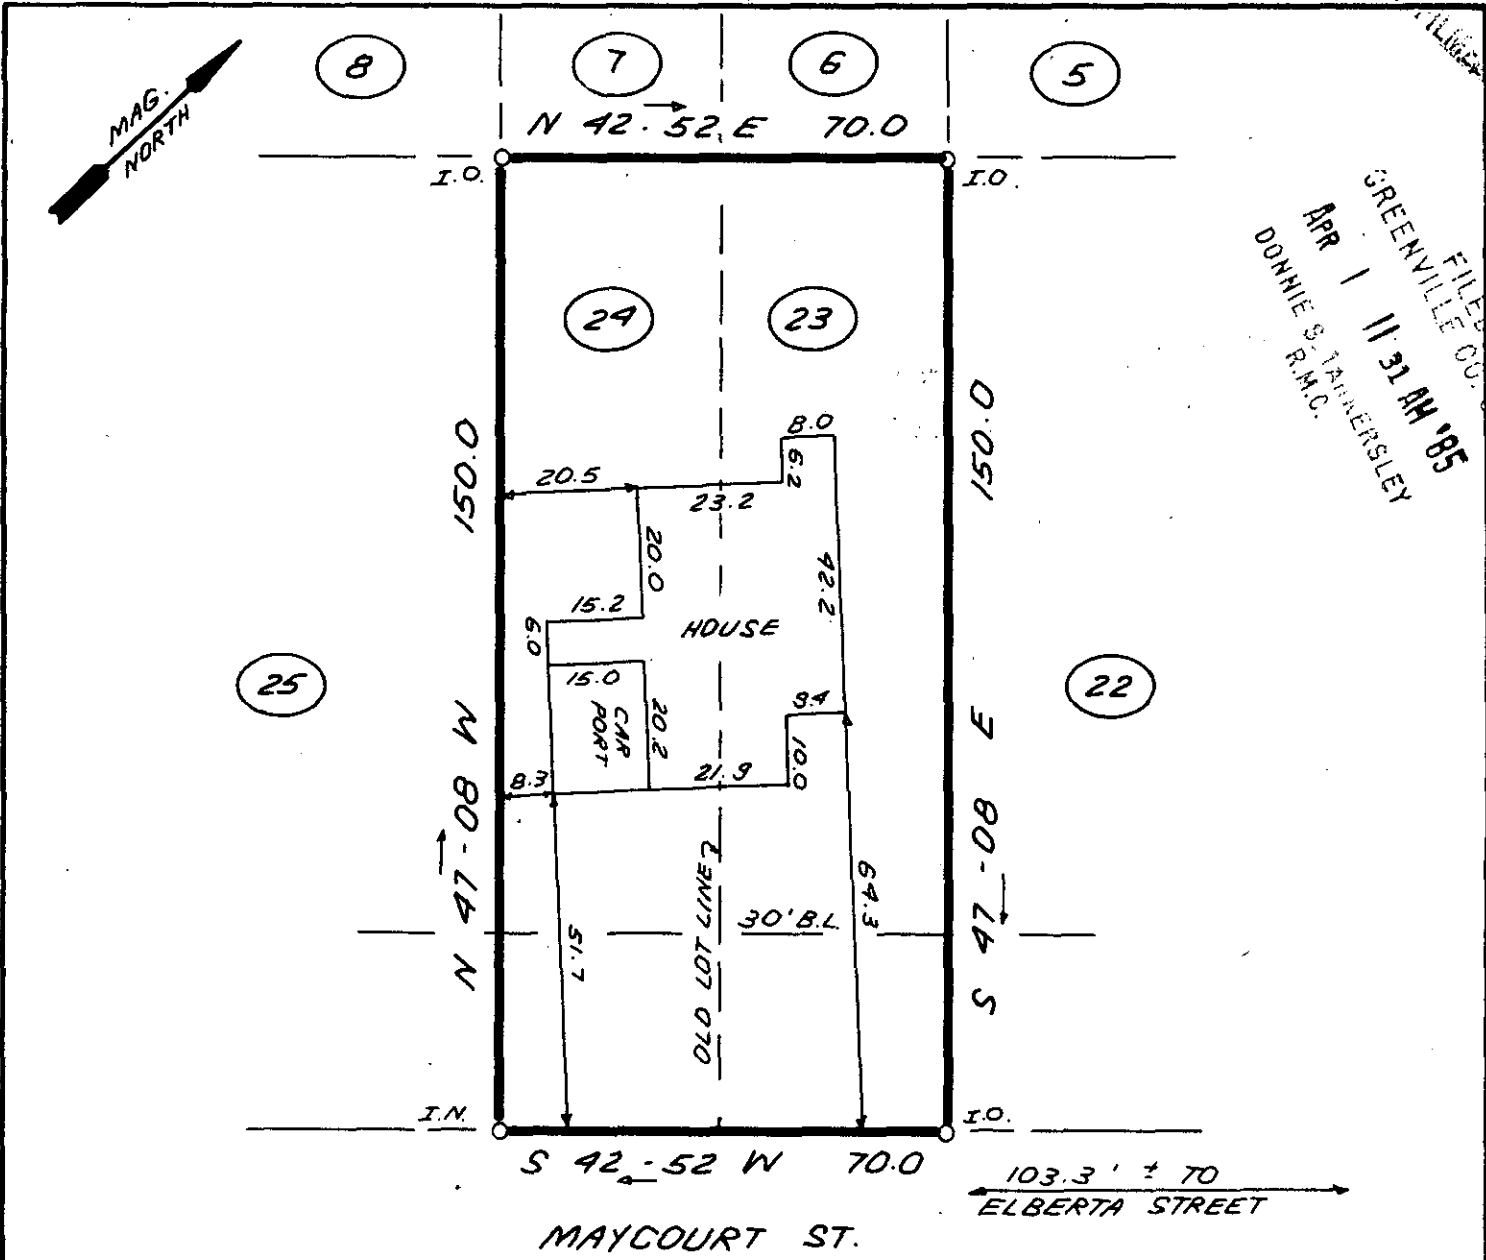

103.3' ± TO  
ELBERTA STREET

MAYCOURT ST.

APR 1 1985

11 L-35 29073



THIS IS TO CERTIFY THAT THE PROPERTY SHOWN ON THIS PLAT WAS SURVEYED UNDER MY DIRECT SUPERVISION. PROPERTY LINES AND IMPROVEMENTS SHOWN ARE LOCATED CORRECTLY AND THAT NO VISIBLE ENCROACHMENTS EXIST UNLESS OTHERWISE SHOWN. THIS PROPERTY IS NOT LOCATED IN A DESIGNATED FLOOD HAZARD AREA.

STATE OF SOUTH CAROLINA  
GREENVILLE COUNTY

FREELAND & ASSOCIATES  
Engineers • Land Surveyors  
318 WEST STONE AVENUE.  
GREENVILLE, S.C.  
(803) 271-4924

BUENA VISTA  
BLOCK F, LOTS 23 & 24  
PROPERTY OF  
INEZ C. ROSAMOND

PLAT BOOK	W@11 E 29
DEED BOOK	
TAX MAP	
PARTY CHIEF	R.A.J.
DRAWN	K.E.G.
DATE	MARCH 4, 1985
DWG. NO.	12555

