

MICROFILMS

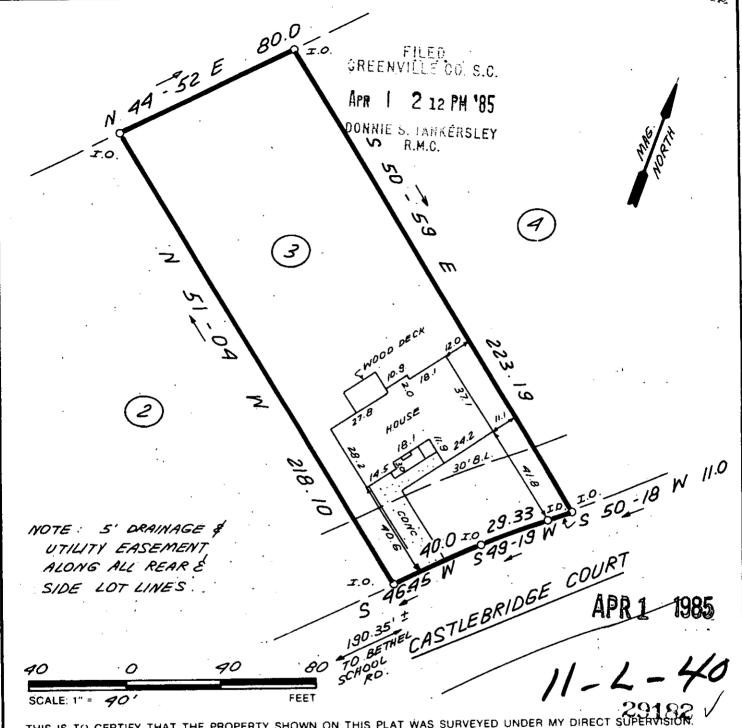

THIS IS TO CERTIFY THAT THE PROPERTY SHOWN ON THIS PLAT WAS SURVEYED UNDER MY DIRECT SUPERVISION. PROPERTY LINES AND IMPROVEMENTS SHOWN ARE LOCATED CORRECTLY AND THAT NO VISIBLE ENCROACHMENTS EXIST UNLESS OTHERWISE SHOWN. THIS PROPERTY IS NOT LOCATED IN A DESIGNATED FLOOD HAZARD AREA.

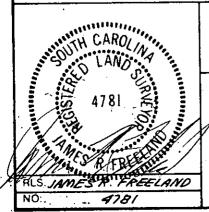

STATE OF SOUTH CAROLINA GREENVILLE COUNTY

HARROGATE HILLS

LOT 3

PROPERTY OF

JACK M. KNIGHT JR.

CHERYL S. KNIGHT

FREELAND & ASSOCIATES

Engineers • Land Surveyors 318 WEST STONE AVENUE. GREENVILLE, S.C. (803) 271-4924

PLAT BOOK	3W@ 47
DEED BOOK	
TAX MAP 2	91 - 1 - 133
PARTY CHIEF	J.C.C.
DRAWN	K.E.G
DATE '	3 - 27 - 85
DWG. NO.	12702

3.00 s

11801