


MICROFILMED

2 MPB
1985

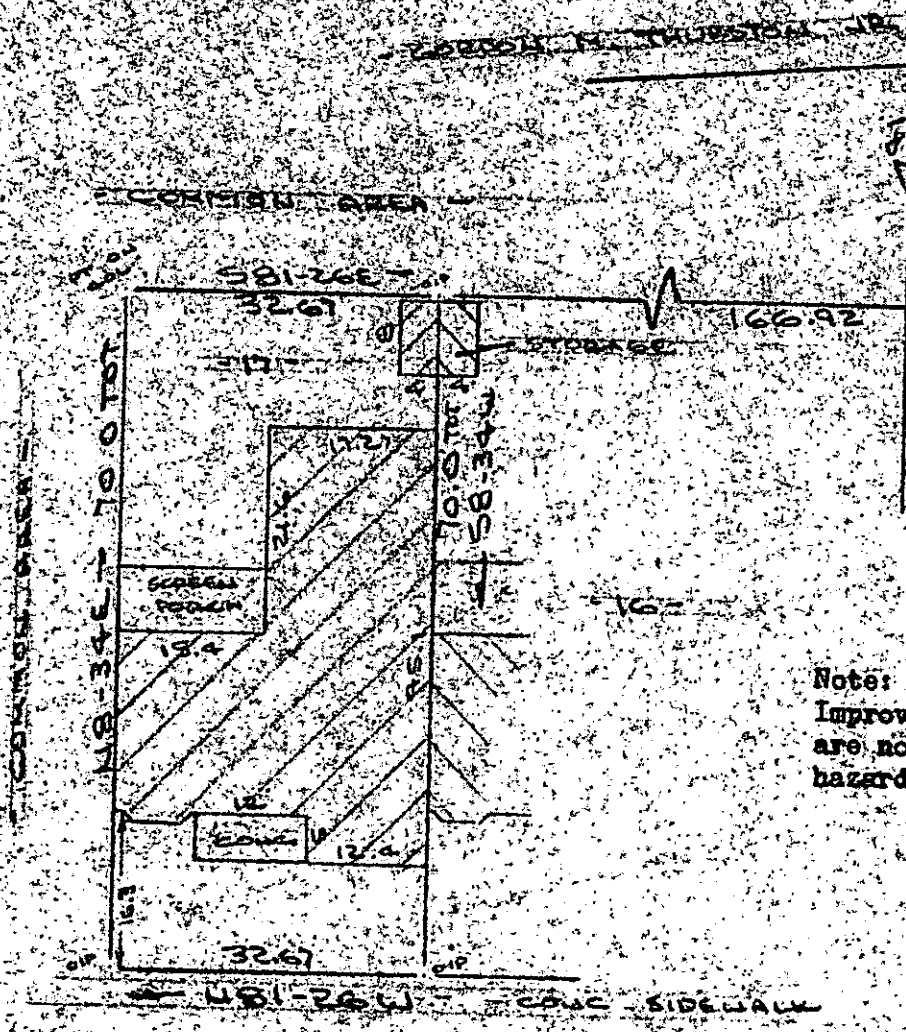

Note:
Improvements on this lot
are not in a flood
hazard area.

ADJACENT PARKING
WATER & SEWER AVAILABLE

PROPERTY OF
PHYLLIS F. OSBORNE
NEAR GREENVILLE, S.C.
SCALE 1/2" = 20' 21 MAR 1985

FILED
GREENVILLE CO. S.C.
APR 2 11 19 AM '85
DONNIE S. JAMES
R.M.O.



This is to certify that on the 21st day of March, 1985, I surveyed the property shown on this plat, being known as lot 17 on plat of FOREST LAKE SECTION 1 PHASE 1 and recorded in the EMC Office Greenville County, S. C., in Plat Book " 11 - I " at Page 6; and that the property lines, walls and buildings are as shown hereon, and that the walls and buildings located on said lot do not encroach or project on adjacent street or property, and that no adjacent walls or buildings encroach or project on said premises, and no power lines cross this property except as shown hereon.

29380 ✓

11-2-61

APR 2 1985 R. B. Bruce
R. B. Bruce, RLS # 1952

CAROLINA SURVEYING co. Recordable Plat
112 Manly St.
Greenville, S. C.