


FILED
GREENVILLE CO., S.C.

APR 11 4 17 PM '85
GILDER

DONNIE S. JANKERS
M.C. 5


RICELAN CREEK IS THE LINE

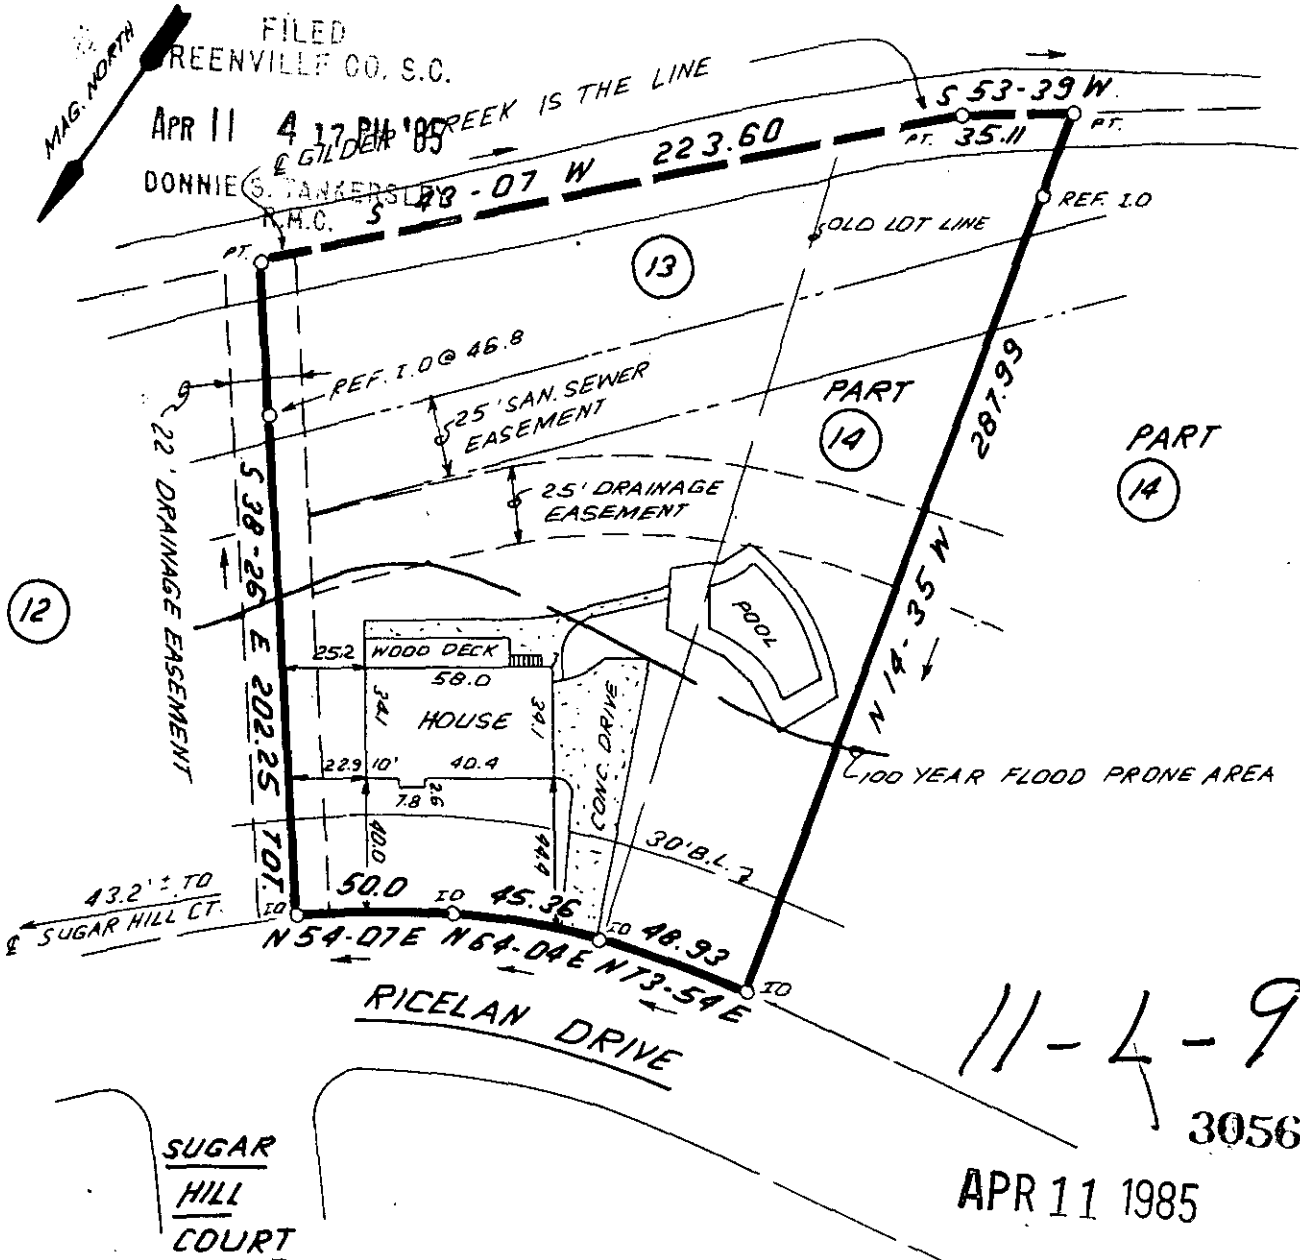

11-4-93

30565

APR 11 1985

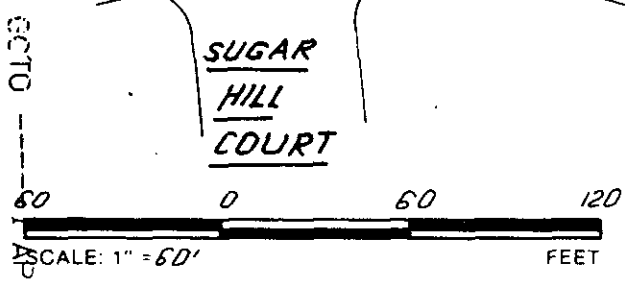

NOTE: 5' DRAINAGE & UTILITY EASEMENT ALONG ALL SIDE & REAR LOT LINES.

THIS IS TO CERTIFY THAT THE PROPERTY SHOWN ON THIS PLAT WAS SURVEYED UNDER MY DIRECT SUPERVISION
PROPERTY LINES AND IMPROVEMENTS SHOWN ARE LOCATED CORRECTLY AND THAT NO VISIBLE ENCROACHMENTS
EXIST UNLESS OTHERWISE SHOWN. THIS PROPERTY IS NOT LOCATED IN A DESIGNATED FLOOD HAZARD AREA

017

APR 11 1985

RLS JAMES R. FREELAND
NO. 4781

**STATE OF SOUTH CAROLINA
GREENVILLE COUNTY**

RICELAN CREEK
LOT 13 & PT LOT 14
PROPERTY OF
JAMES R. WILKINS
DE ANN WILKINS

FREELAND & ASSOCIATES
Engineers • Land Surveyors
318 WEST STONE AVENUE.
GREENVILLE, S.C.
(803) 271-4924

PLAT BOOK	9W-8
DEED BOOK	
TAX MAP	
PARTY CHIEF	B.G.
DRAWN	I.R.
DATE	4-8-85
DWG NO.	12772