


FILED
GREENVILLE CO. S.C.
APR 12 3 45 PM '85
DONNIE S. TARKERSLEY
R.M.C.

80
SEC. 1

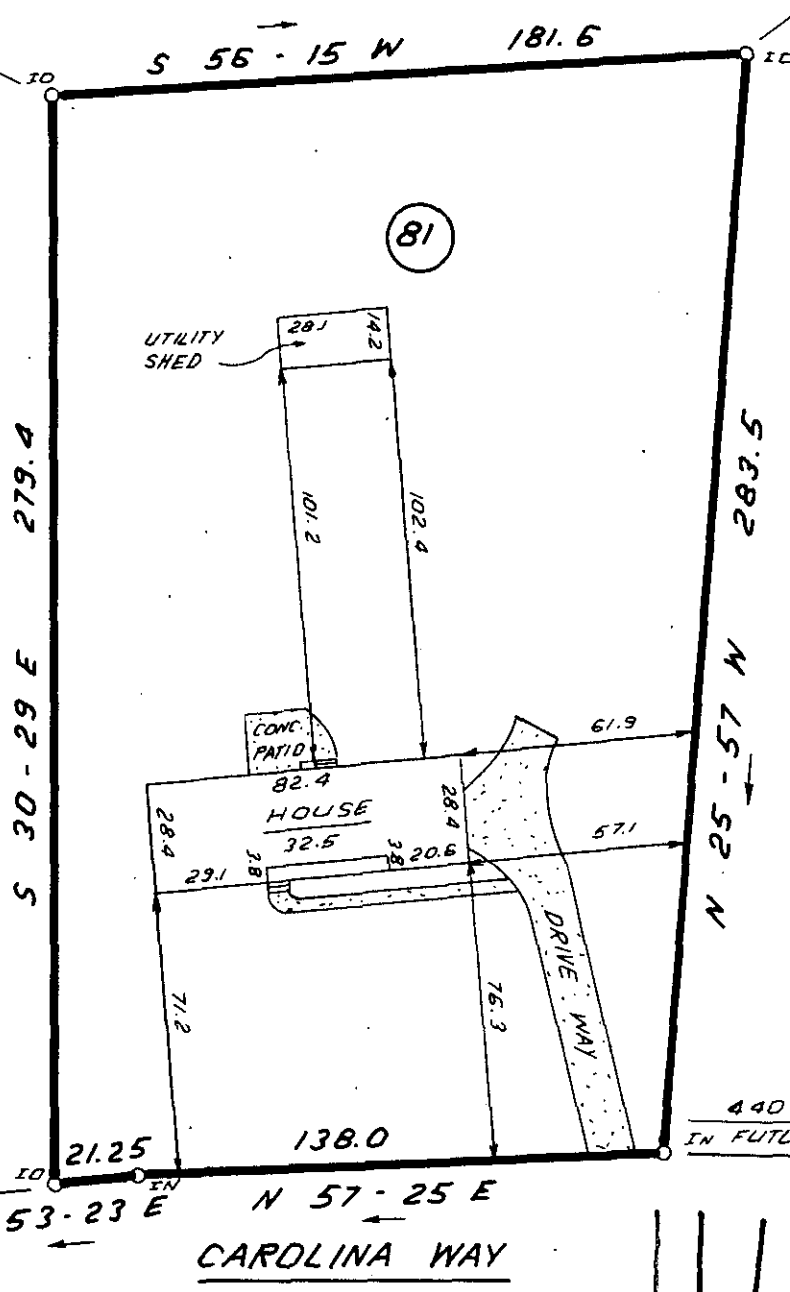

82

APR 12 1985

440'± TO
IN FUTURE ROAD

30700

11L-97

GC10
APR 12 1985



NOTE: 5' DRAINAGE & UTILITY EASEMENT ALONG ALL SIDE & REAR LOT LINES.

THIS IS TO CERTIFY THAT THE PROPERTY SHOWN ON THIS PLAT WAS SURVEYED UNDER MY DIRECT SUPERVISION PROPERTY LINES AND IMPROVEMENTS SHOWN ARE LOCATED CORRECTLY AND THAT NO VISIBLE ENCROACHMENTS EXIST UNLESS OTHERWISE SHOWN. THIS PROPERTY IS NOT LOCATED IN A DESIGNATED FLOOD HAZARD AREA

STATE OF SOUTH CAROLINA
GREENVILLE COUNTY

FREELAND & ASSOCIATES
Engineers • Land Surveyors
318 WEST STONE AVENUE.
GREENVILLE, S.C.
(803) 271-4924

COUNTRY ESTATES
SEC. 2 ; LOT 81
PROPERTY OF
ROBERT A. FORNSHELL
DENISE A. FORNSHELL

PLAT BOOK	5R-72
DEED BOOK	1233-483
TAX MAP	555.5-1-39
PARTY CHIEF	R.J.
DRAWN	I.R.
DATE	4-10-85
DWG. NO	12784

JAMES R. FREELAND
NO: 4781