
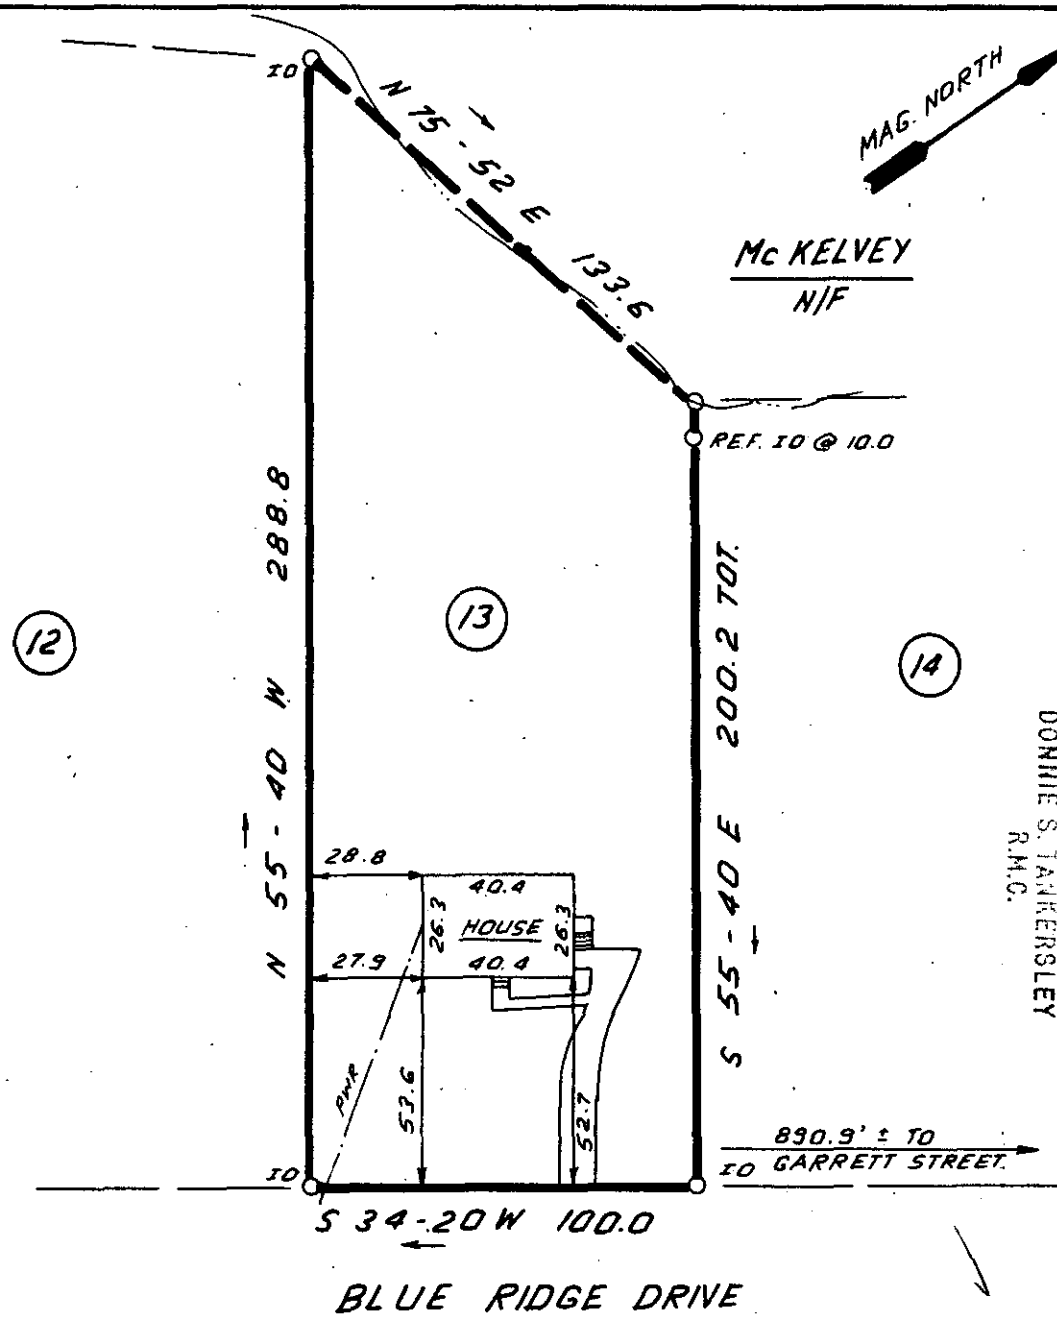


MICROFILMED

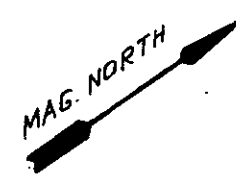

FILED
 GREENVILLE CO. S.C.
 APR 12 4 51 PM '85
 DONNIE S. JANKERSLEY
 R.M.C.

30746

11-L-99



THIS IS TO CERTIFY THAT THE PROPERTY SHOWN ON THIS PLAT WAS SURVEYED UNDER MY DIRECT SUPERVISION PROPERTY LINES AND IMPROVEMENTS SHOWN ARE LOCATED CORRECTLY AND THAT NO VISIBLE ENCROACHMENTS EXIST UNLESS OTHERWISE SHOWN. THIS PROPERTY IS NOT LOCATED IN A DESIGNATED FLOOD HAZARD AREA

**STATE OF SOUTH CAROLINA
 GREENVILLE COUNTY**

FREELAND & ASSOCIATES
 Engineers • Land Surveyors
 318 WEST STONE AVENUE.
 GREENVILLE, S.C.
 (803) 271-4924

WOODFIELD HEIGHTS
SEC. 2; LOT 13
PROPERTY OF
ANDREW M. DU BROVSKY
MARGIE W. DU BROVSKY

PLAT BOOK	PPP - 109
DEED BOOK	1177 - 749
TAX MAP	306 - 1 - 107
PARTY CHIEF	R. J.
DRAWN	J. R.
DATE	4 - 10 - 85
DWG. NO.	12785

R.S. JAMES R. FREELAND
 NO. 4781

2 API 2 85 019

3.00CI