
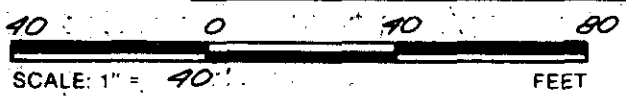


FILED  
GREENVILLE CO. S.C.  
APR 16 10 01 AM '85  
DONNIE S. LANKERSLEY  
R.M.C.

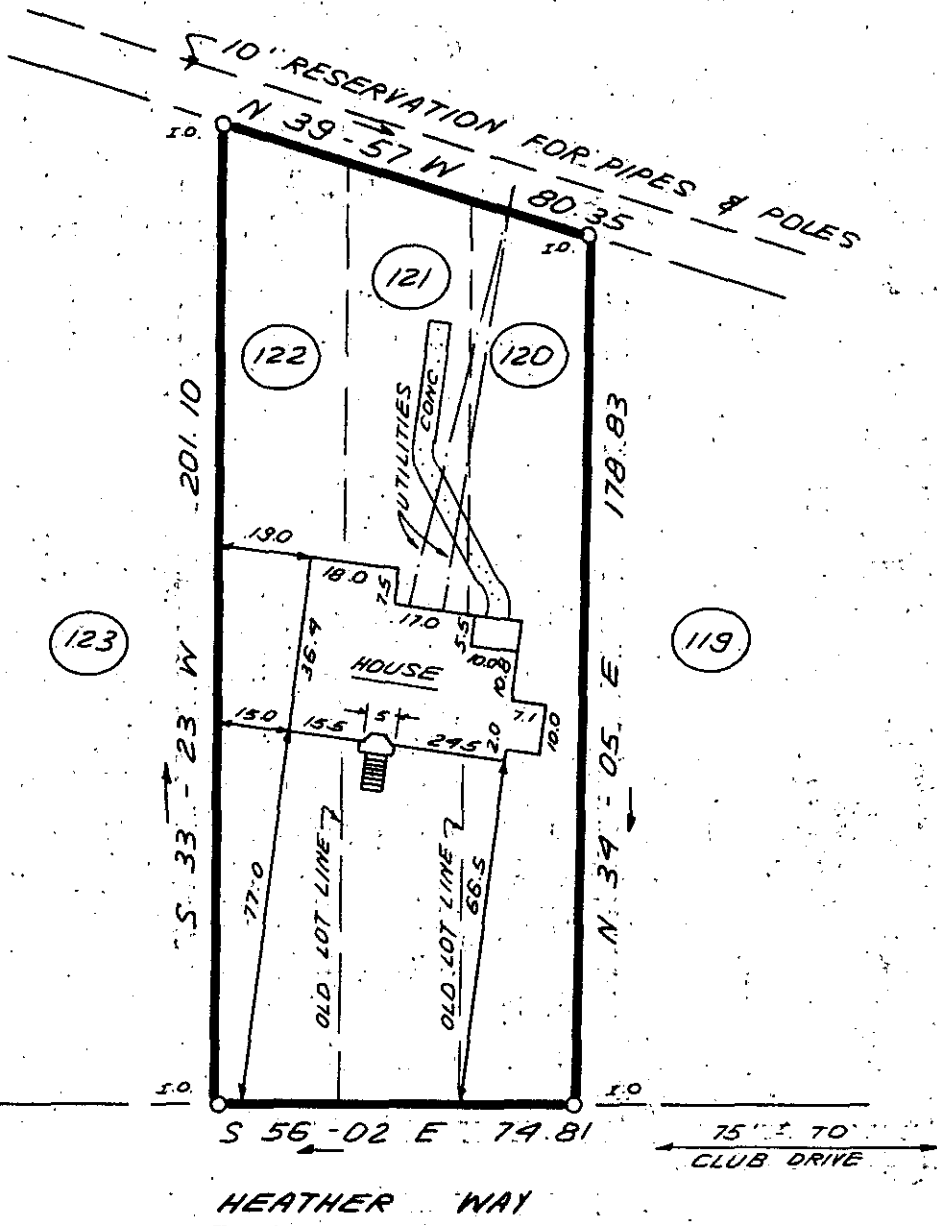


11-M-6 31096

THIS IS TO CERTIFY THAT THE PROPERTY SHOWN ON THIS PLAT WAS SURVEYED UNDER MY DIRECT SUPERVISION. PROPERTY LINES AND IMPROVEMENTS SHOWN ARE LOCATED CORRECTLY AND THAT NO VISIBLE ENCROACHMENTS EXIST UNLESS OTHERWISE SHOWN. THIS PROPERTY IS NOT LOCATED IN A DESIGNATED FLOOD HAZARD AREA.

**STATE OF SOUTH CAROLINA  
GREENVILLE COUNTY**

**FREELAND & ASSOCIATES**  
Engineers • Land Surveyors  
318 WEST STONE AVENUE  
GREENVILLE, S.C.  
(803) 271-4924

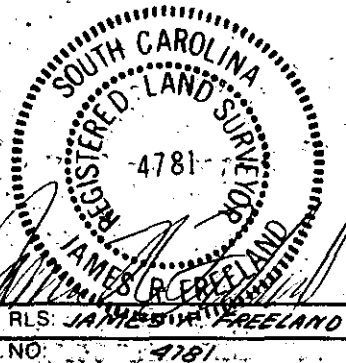

MARSHALL FOREST  
LOTS 120, 121, & 122  
PROPERTY OF  
EILEEN DELASANDRO

PLAT BOOK	H.C. 134
DEED BOOK	
TAX MAP	210-5-5
PARTY CHIEF	B.G.
DRAWN	K.E.G.
DATE	4-2-85
DWG. NO.	12743