



FILED
GREENVILLE CO. S.C.
APR 26 12 32 PM '85
DONNIE S. TARKERSLEY
R.M.C.

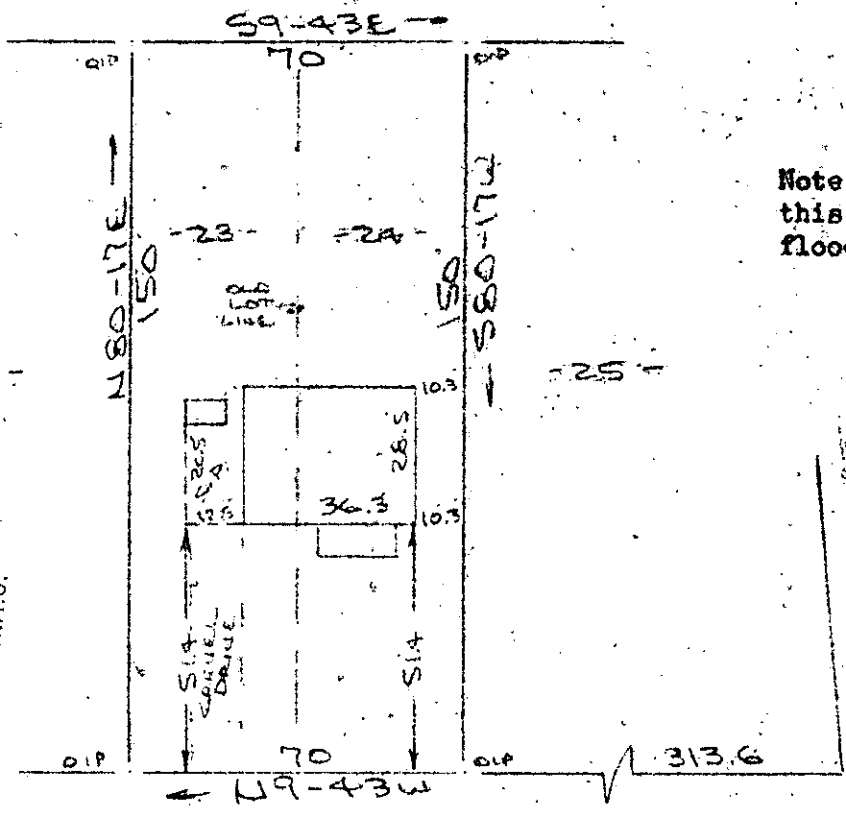

Note: Improvements on this lot are not in a flood hazard area.

PROPERTY OF
JACKSON B. TURNER & CAROL LYNN TURNER
NEAR GREENVILLE, S.C.
SCALE: 1"=40' 18 APR 1985

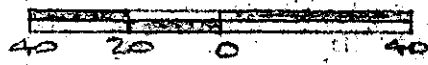

APR 26 1985

This is to certify that on the 16th day of April, 1985, I surveyed the property shown on this plat, being known as lots 23 & 24 on plat of BUENA VISTA and recorded in the RMC Office Greenville County, S. O., in Plat Book "W" at Page 29; and that the property lines, walls and buildings are as shown hereon, and that the walls and buildings located on said lot do not encroach or project on adjacent street or property, and that no adjacent walls or buildings encroach or project on said premises, and no power lines cross this property except as shown hereon.

11-M-47

32392

R. B. Bruce

R. B. Bruce, RLS # 1952

CAROLINA SURVEYING CO.
112 Manly St.
Greenville, S. C.

Recordable Plat

300.3
11A01