


32298


APR 26 1985

11-M-48

FILED
GREENVILLE CO. S.C.
APR 26 2 12 PM '85
DONNIE S. JANKERSLEY
R.M.C.

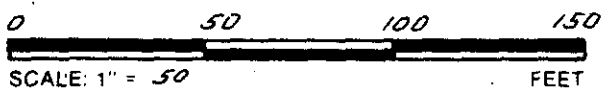

THIS IS TO CERTIFY THAT THE PROPERTY SHOWN ON THIS PLAT WAS SURVEYED UNDER MY DIRECT SUPERVISION. PROPERTY LINES AND IMPROVEMENTS SHOWN ARE LOCATED CORRECTLY AND THAT NO VISIBLE ENCROACHMENTS EXIST UNLESS OTHERWISE SHOWN. THIS PROPERTY IS NOT LOCATED IN A DESIGNATED FLOOD HAZARD AREA.

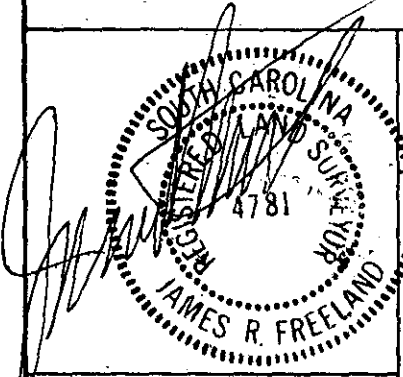

STATE OF SOUTH CAROLINA
GREENVILLE COUNTY

PILGRIMS POINT
LOT 8
PROPERTY OF
JAMES H. BROWN
LYNN O. BROWN

FREELAND & ASSOCIATES
Engineers • Land Surveyors
318 WEST STONE AVENUE.
GREENVILLE, S.C.
(803) 271-4924

PLAT BOOK	WW W 35
DEED BOOK	1021-876
TAX MAP	543.8-1-8
PARTY CHIEF	L.T.
DRAWN	B. R.
DATE	4-25-85
DWG. NO.	12882

RLS: JAMES R. FREELAND
NO: 4781