MICROFILMED

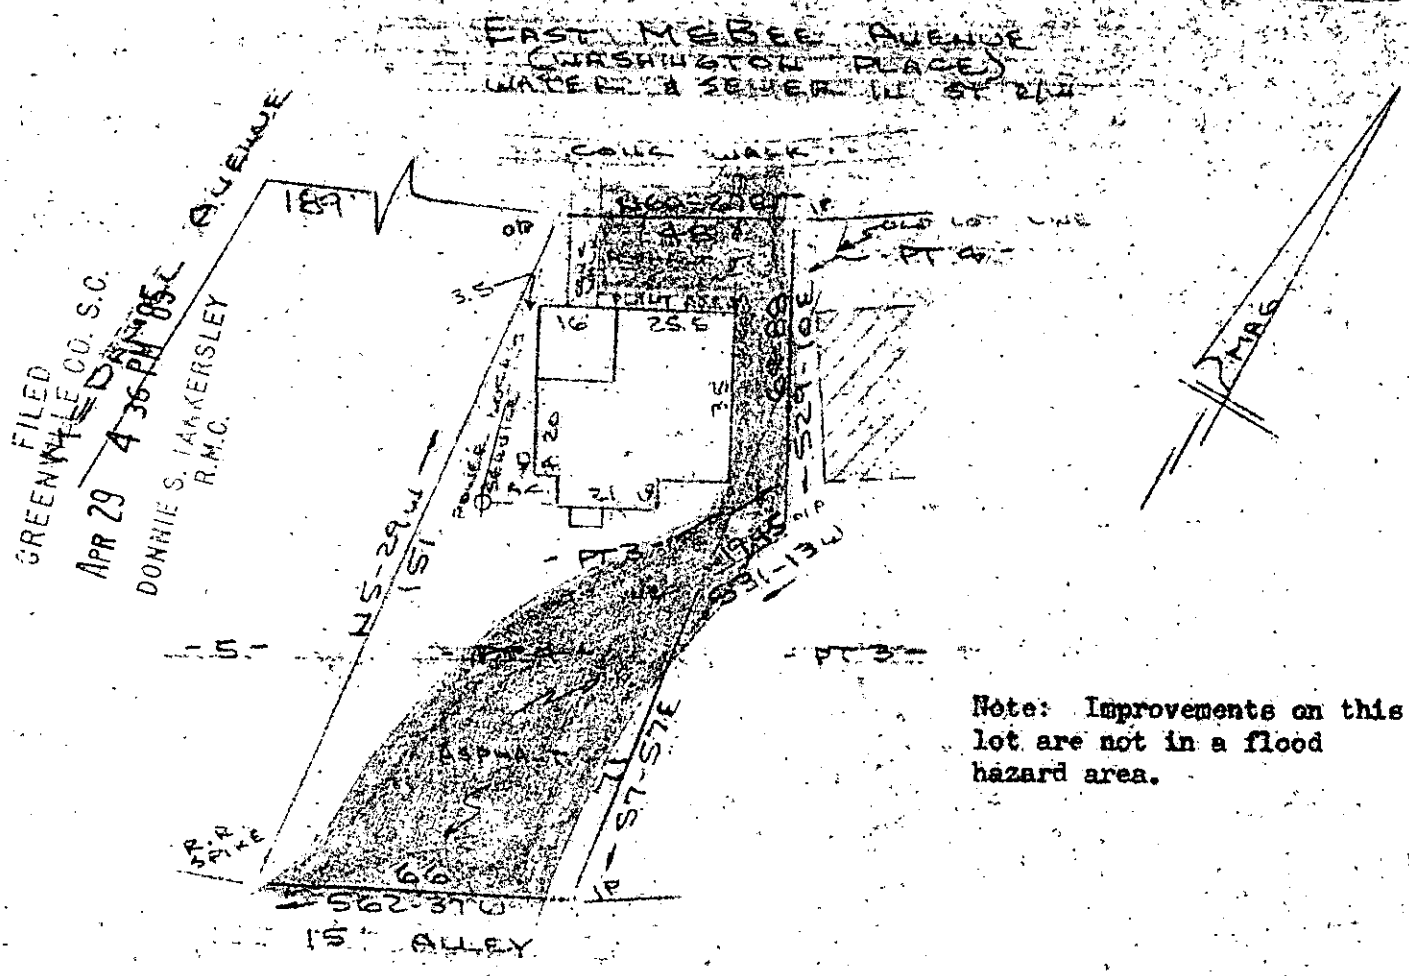

Note: Improvements on this lot are not in a flood hazard area.

AS BUILT SURVEY FOR
JOHN I. MAULDIN & JAMES M. ALLISON
GREENVILLE COUNTY, GREENVILLE, S.C.
SCALE: 1" = 40' 23 APR 1985

This is to certify that on the 23rd day of April, 1985, I surveyed the property shown on this plat, being known as part of lot 4 and part of lot 3 on plat of W. Daniel Yarborough, George N. Funderburk and David W. Glenn and recorded in the RMC Office Greenville County, S. C., in Plat Book " 6 - D " at Page 92 also plat of W. Daniel Yarborough, George N. Funderburk and David W. Glenn and recorded in Plat Book " 6 - F " at Page 19 also known as AS BUILT SURVEY FOR JOHN I. MAULDIN & JAMES M. ALLISON and recorded in Plat Book at Page ; and that the property lines, walls and buildings are as shown hereon, and that the walls and buildings located on said lot do not encroach or project on adjacent street or property, and that no adjacent walls or buildings encroach or project on said premises, and no power lines cross this property except as shown hereon.

32522

11M-67

APR 29 1985

R. B. Bruce

R. B. Bruce, RLS # 1952

CAROLINA SURVEYING CO.
112 Manly St.
Greenville, S. C.

Recordable Plat

GCTC -- 3 AP29 85 500 3-00CI