


GREENVILLE COUNTRY CLUB

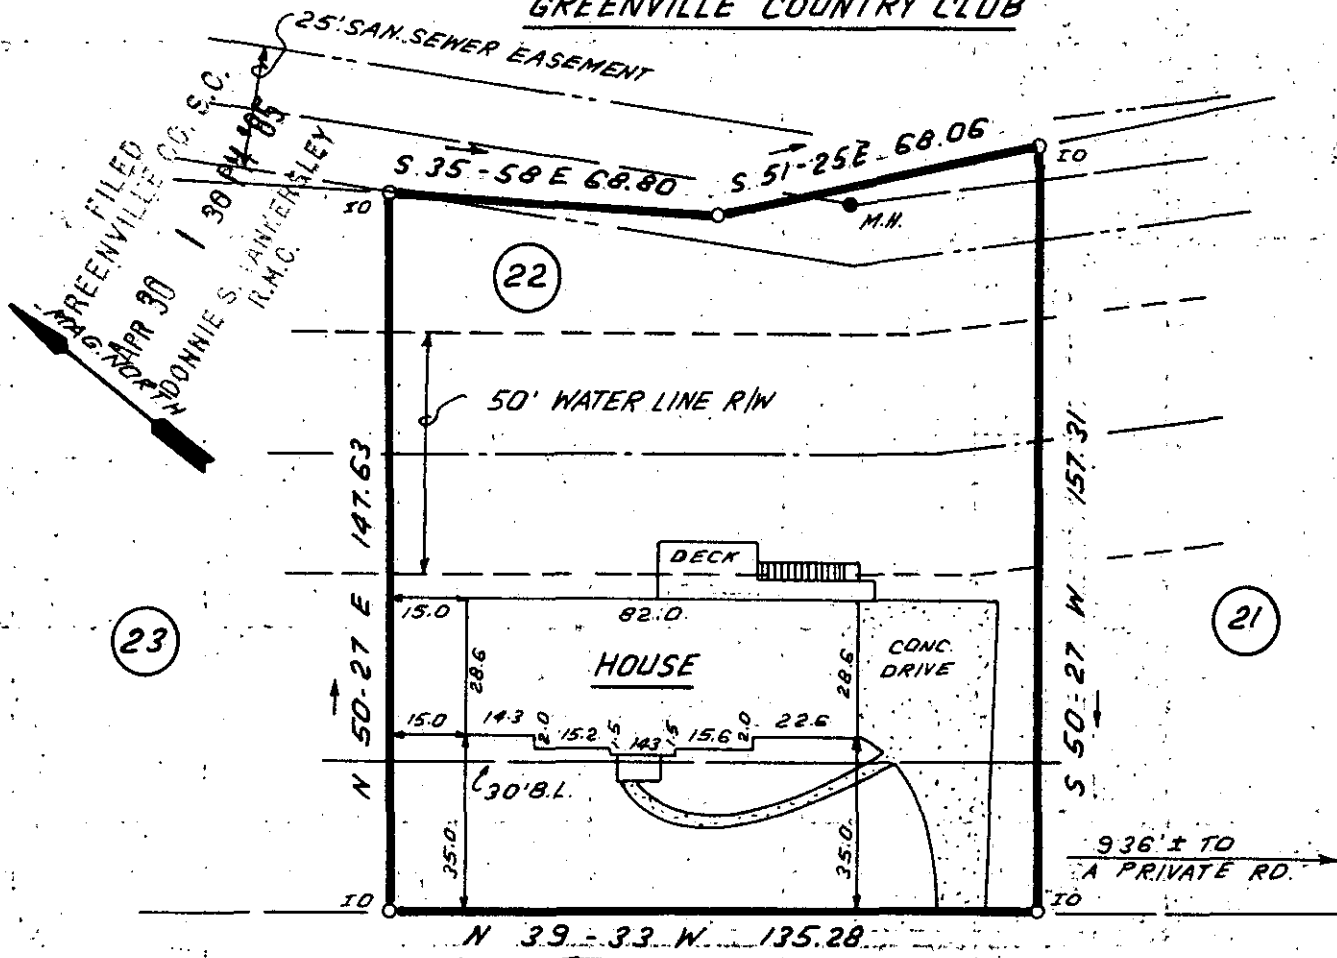

APR 30 1985

CLUB FOREST LANE

11-M-76

32630 ✓



NOTE: 5' DRAINAGE & UTILITY EASEMENT ALONG ALL SIDE LOT LINES & 10' ALONG ALL REAR LOT LINES

THIS IS TO CERTIFY THAT THE PROPERTY SHOWN ON THIS PLAT WAS SURVEYED UNDER MY DIRECT SUPERVISION. PROPERTY LINES AND IMPROVEMENTS SHOWN ARE LOCATED CORRECTLY AND THAT NO VISIBLE ENCROACHMENTS EXIST UNLESS OTHERWISE SHOWN. THIS PROPERTY IS NOT LOCATED IN A DESIGNATED FLOOD HAZARD AREA

STATE OF SOUTH CAROLINA GREENVILLE COUNTY

FREELAND & ASSOCIATES Engineers • Land Surveyors 318 WEST STONE AVENUE. GREENVILLE, S.C. (803) 271-4924

CLUB FOREST LOT 22 PROPERTY OF WILLIAM T. FREELAND CAROLYN Z. FREELAND

PLAT BOOK	
DEED BOOK	
TAX MAP	
PARTY CHIEF	J.C.C.
DRAWN	I.R.
DATE	4-23-85
DWG. NO.	12863

RLS: JAMES R. FREELAND
NO: 4781