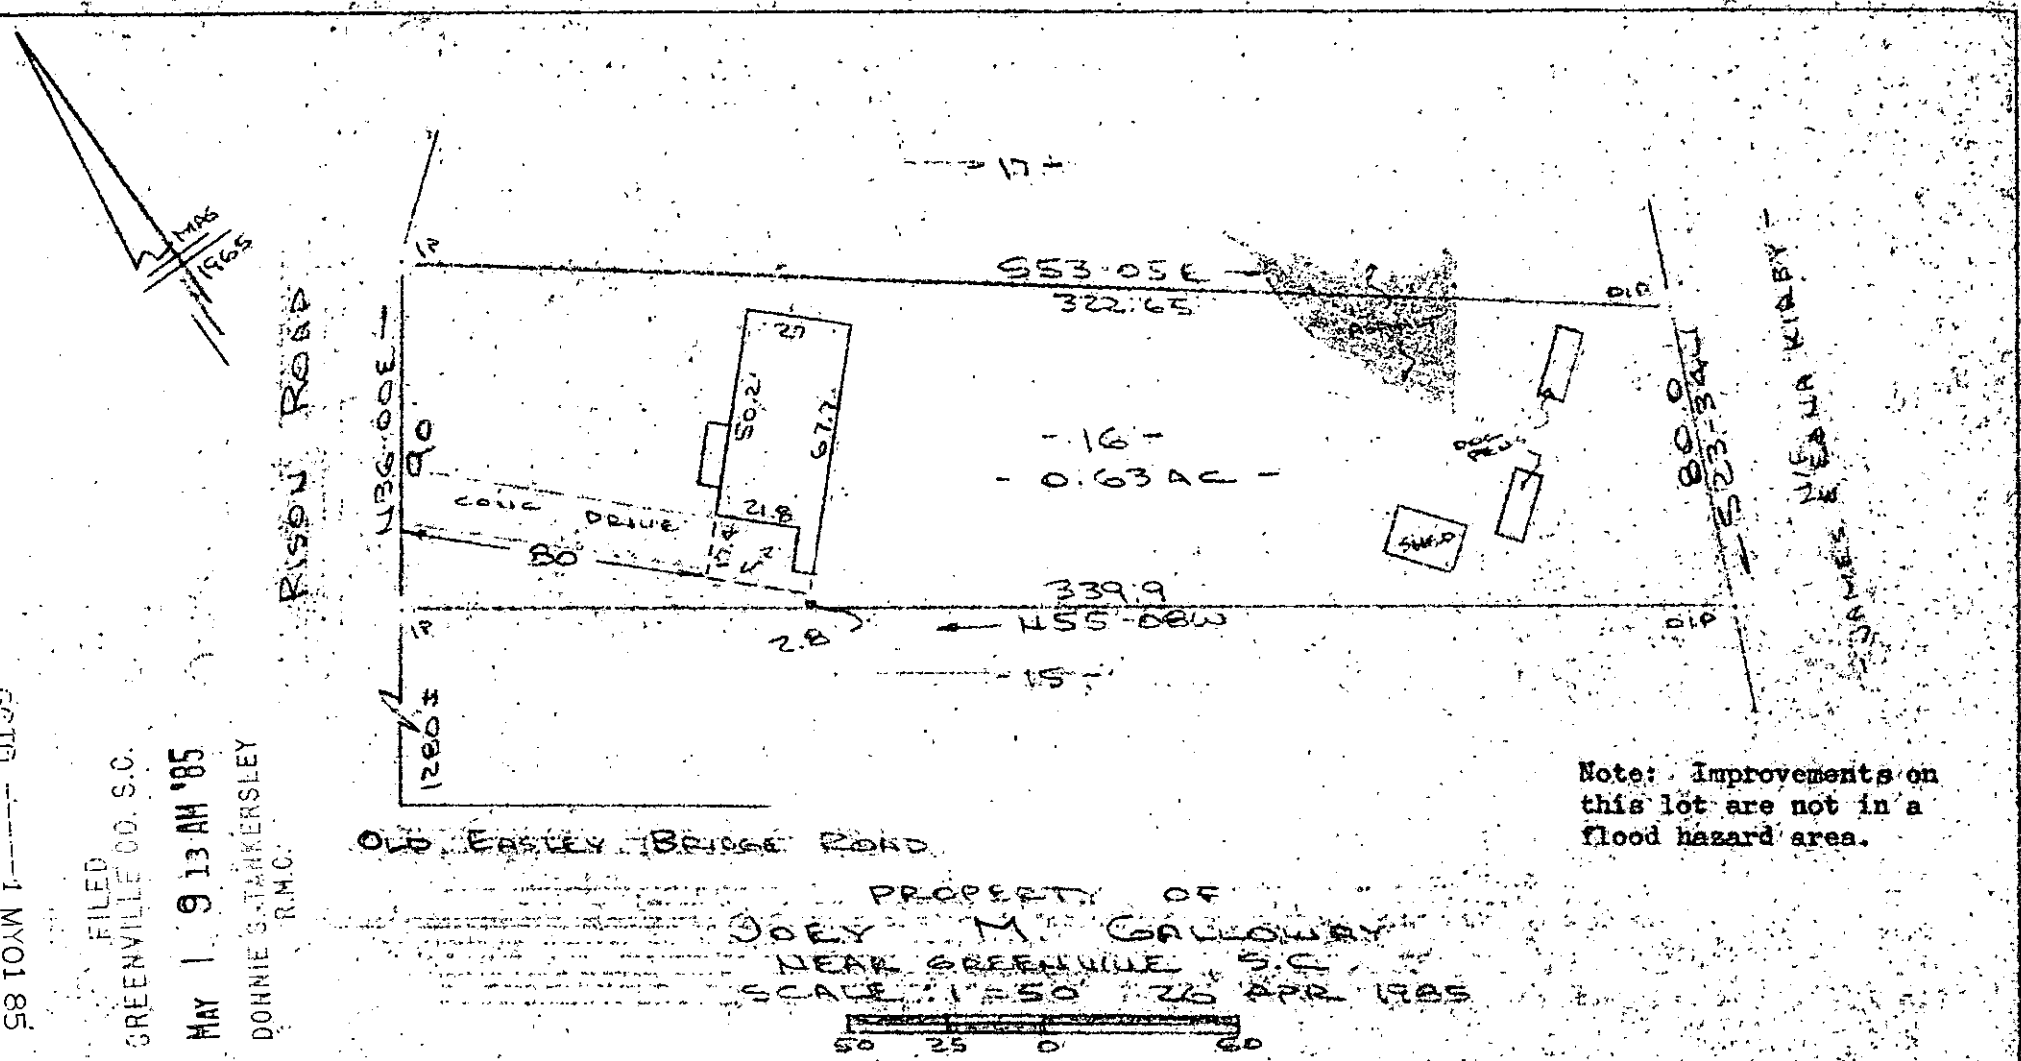

Note: Improvements on this lot are not in a flood hazard area.

FILED
GREENVILLE CO. S.C.
MAY 1 9 13 AM '85
DONNIE S. TANKERSLEY
R.M.C.

This is to certify that on the 26th day of April, 1985, I surveyed the property shown on this plat, being known as lot 16 on plat of JAMES ARROWOOD and recorded in the RMC Office Greenville County, S. C., in Plat Book " RR " at Page 45 and also known as PROPERTY OF JOEY M. GALLOWAY and recorded in Plat Book at Page ; and that the property lines, walls and buildings are as shown hereon, and that the walls and buildings located on said lot do not encroach or project on adjacent street or property, and that no adjacent walls or buildings encroach or project on said premises, and no power lines cross this property except as shown hereon.

11-M-79 32924

R. B. Bruce

R. B. Bruce, RLS # 1952

CAROLINA SURVEYING CO.
112 Manly St., Greenville, S. C.

Recordable Plat

MICROFILMED

GCTO ----1 MY01 85 016

3.00CD

289/18

239.2-7-16