
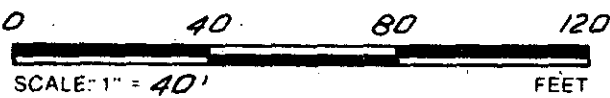


SCHOOL DISTRICT OF GREENVILLE CO.

MICROFILMED

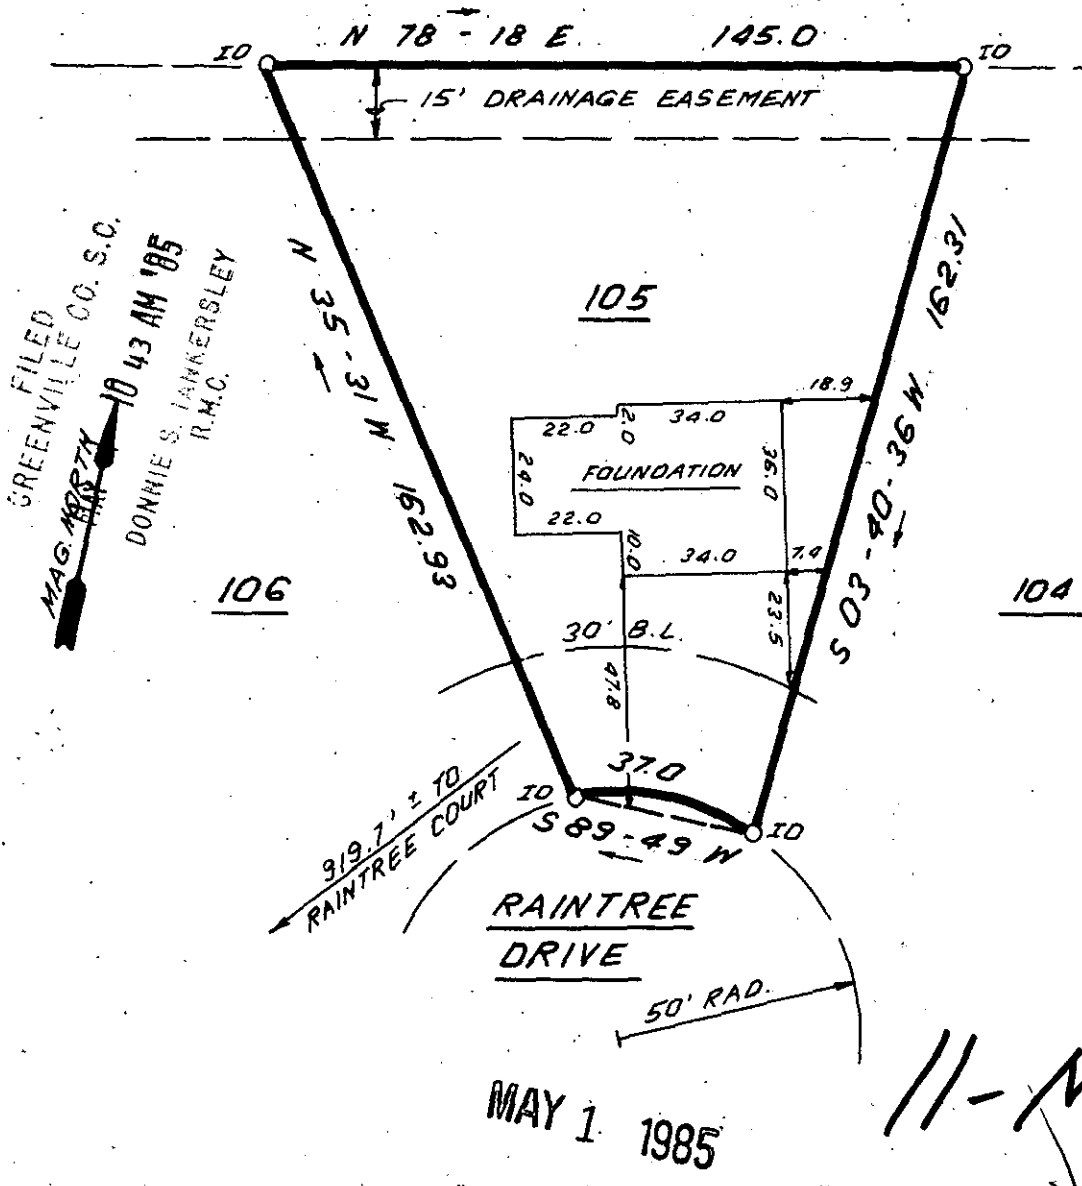

NOTE: 5' DRAINAGE & UTILITY EASEMENT EACH SIDE ALL SIDE & REAR LOT LINES UNLESS OTHERWISE SHOWN.

THIS IS TO CERTIFY THAT THE PROPERTY SHOWN ON THIS PLAT WAS SURVEYED UNDER MY DIRECT SUPERVISION. PROPERTY LINES AND IMPROVEMENTS SHOWN ARE LOCATED CORRECTLY AND THAT NO VISIBLE ENCROACHMENTS EXIST UNLESS OTHERWISE SHOWN. THIS PROPERTY IS NOT LOCATED IN A DESIGNATED FLOOD HAZARD AREA.

SOUTH CAROLINA REGISTERED LAND SURVEYOR 74781
 JAMES R. FREELAND
 R.L. JAMES R. FREELAND
 NO. 4781

STATE OF SOUTH CAROLINA
 GREENVILLE COUNTY

NORTHWOOD
SEC. 4, LOT 105
PROPERTY OF
NICK McCONNELL
SUSAN McCONNELL

FREELAND & ASSOCIATES Engineers • Land Surveyors 318 WEST STONE AVENUE GREENVILLE, S.C. (803) 271-4924	
PLAT BOOK	10-M-51
DEED BOOK	1203-387
TAX MAP	
PARTY CHIEF	J.E.C.
DRAWN	I.R.
DATE	4-25-85
DWG. NO.	12886

300 3 11A01