MICROFILMED

N. Golden Strip Drive

FILED
GREENVILLE CO. S.C.
MAY 1 11 38 AM '85
DONNIE S. TANKERSLEY
R.M.C.

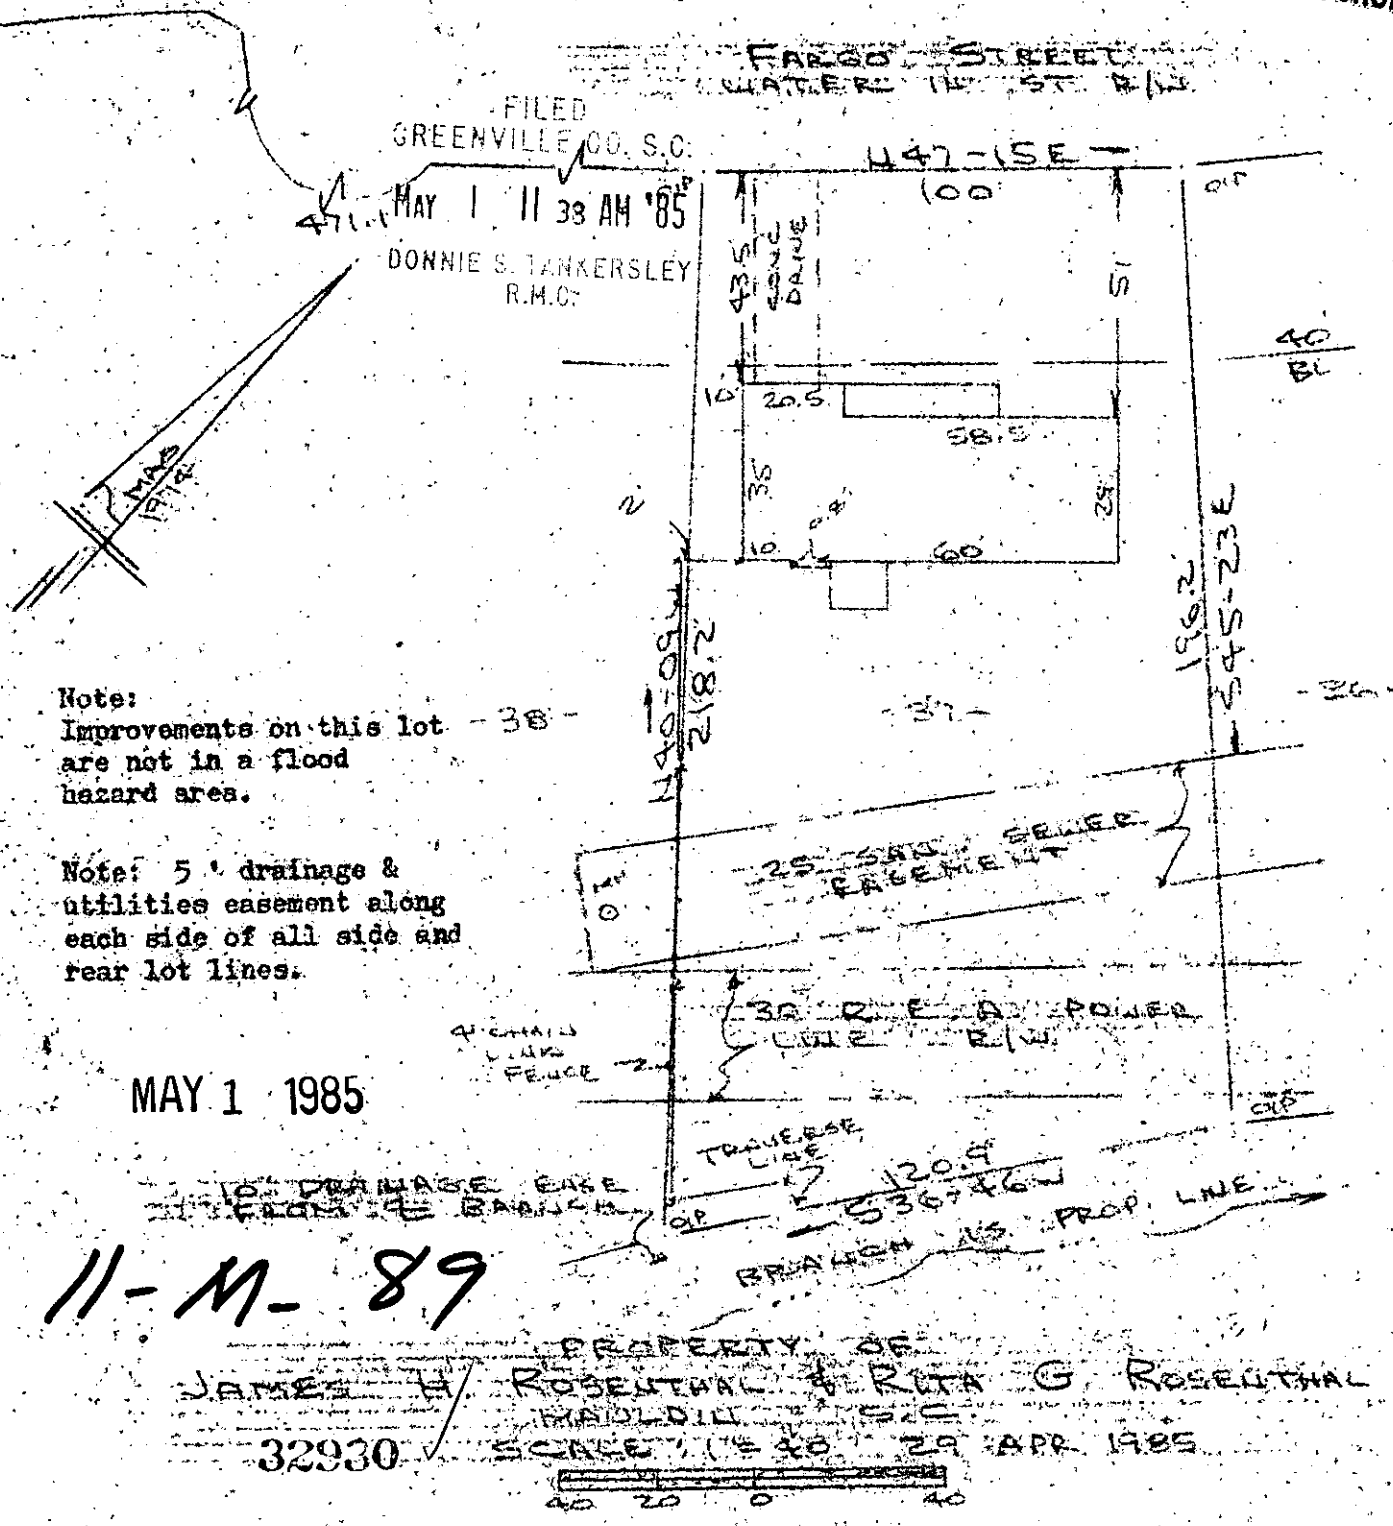

Note:
Improvements on this lot are not in a flood hazard area.

Note: 5' drainage & utilities easement along each side of all side and rear lot lines.

MAY 1 1985

11-M-89

PROPERTY OF
JAMES H. ROSENTHAL & RITA G. ROSENTHAL
32930 SCALE 1" = 40' 29 APR. 1985

This is to certify that on the 29th day of April, 1985, I surveyed the property shown on this plat, being known as lot 37 on plat of Sheet 1 GLENDALE III and recorded in the RMC Office Greenville County, S. C., in Plat Book " 4 - R " at Page 83; and that the property lines, walls and buildings are as shown hereon, and that the walls and buildings located on said lot do not encroach or project on adjacent street or property, and that no adjacent walls or buildings encroach or project on said premises, and no power lines cross this property except as shown hereon.

R. B. Bruce

R. B. Bruce, RLS # 1952

CAROLINA SURVEYING CO.
112 Manly St.
Greenville, S. C.

Recordable Plat

2 MY01 85 029 3.00CI

M42-2-82