


FILED
GREENVILLE CO. S.C.

MAY 1 1 47 PM '85

DONNIE S. FARKERSLEY
R.M.C.

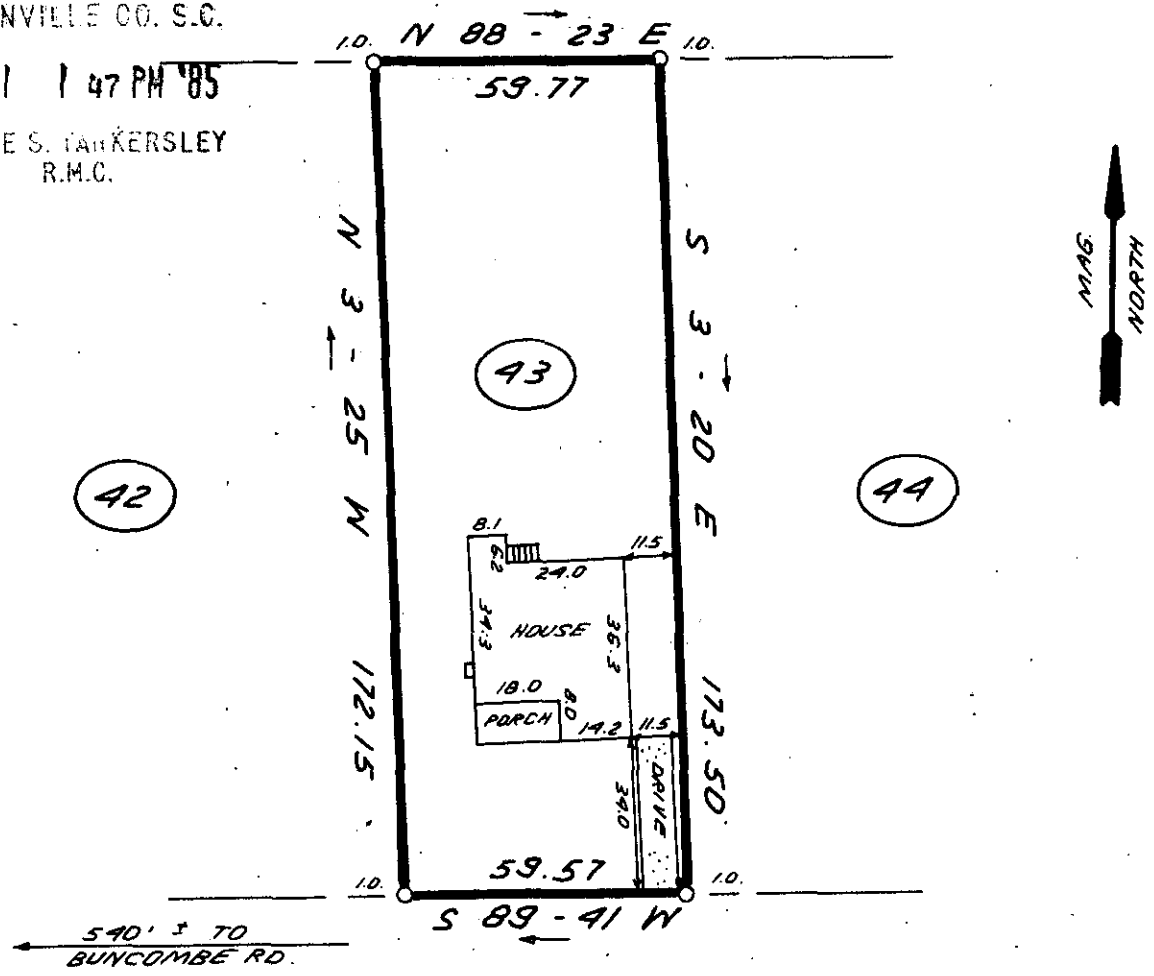

NORTH HAVEN DRIVE

MAY 1 1985



11-M-95
32934

THIS IS TO CERTIFY THAT THE PROPERTY SHOWN ON THIS PLAT WAS SURVEYED UNDER MY DIRECT SUPERVISION. PROPERTY LINES AND IMPROVEMENTS SHOWN ARE LOCATED CORRECTLY AND THAT NO VISIBLE ENCROACHMENTS EXIST UNLESS OTHERWISE SHOWN. THIS PROPERTY IS NOT LOCATED IN A DESIGNATED FLOOD HAZARD AREA.

**STATE OF SOUTH CAROLINA
GREENVILLE COUNTY**

FREELAND & ASSOCIATES
Engineers • Land Surveyors.
318 WEST STONE AVENUE.
GREENVILLE, S.C.
(803) 271-4924

BUNCOMBE PARK
LOT 43
PROPERTY OF
BRETT A. MARTIN
DIANNA GORE MARTIN

PLAT BOOK	MC 12
DEED BOOK	1161-362
TAX MAP	
PARTY CHIEF	J.C.C.
DRAWN	K.E.S. OOOI
DATE	4-29-85
DWG. NO.	12911

REGISTERED LAND SURVEYOR
4781
JAMES S. FREELAND
R.L.S. JAMES S. FREELAND
NO: 4781