MICROFILMED

FILED
GREENVILLE CO. S.C.
MAY 9 10 48 AM '85
DONNIE S. TANKERSLEY
R.M.C.

MAG.

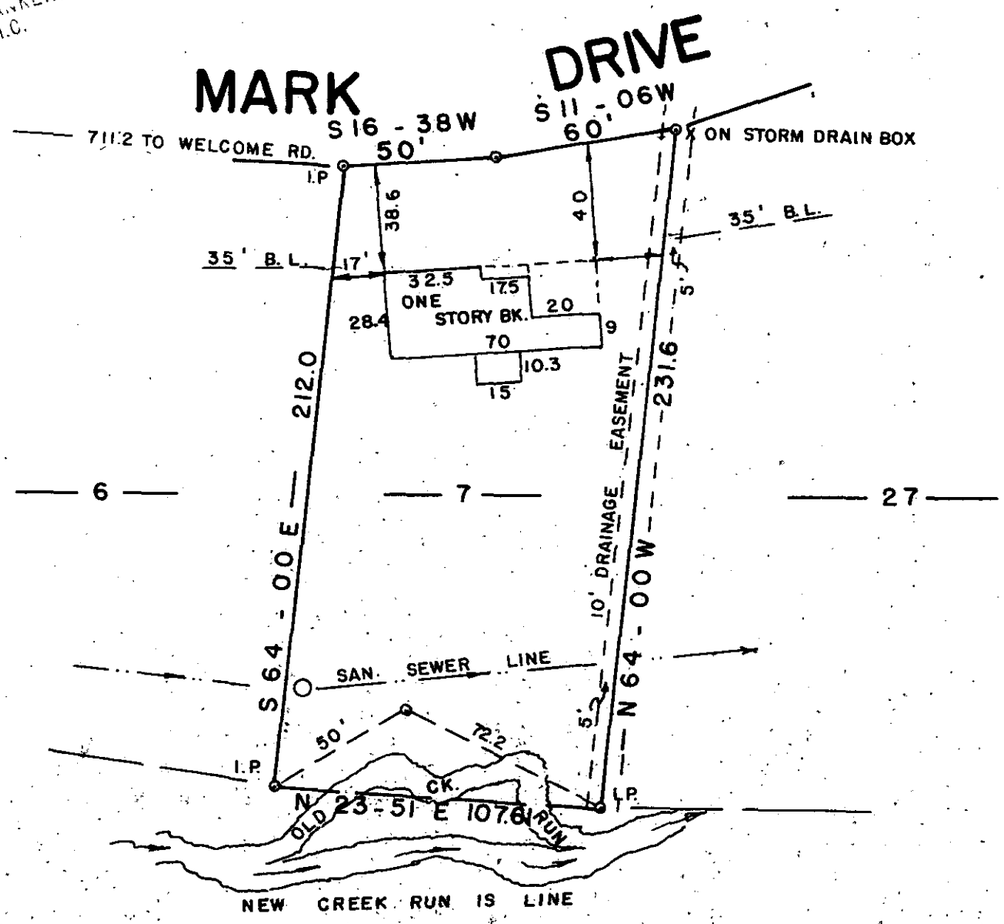

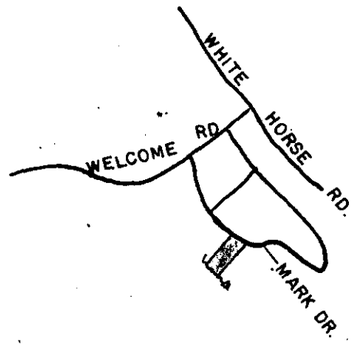

MAY 9 1985

✓ 33975

11-N-20

SURVEY FOR

HOLLAND REEVES

GREENVILLE CO. SOUTH CAROLINA

WEBB SURVEYING & MAPPING GROUP
P.O. BOX 4756 - 29608

50 0 50 100

SCALE 1" = 50 FT.

DATE APRIL 1985

☑ I HEREBY CERTIFY THE RATIO OF PERECSON OF THE FIELD SURVEY IS 1/ 4000 THE AREA WAS DETERMINED BY D M D CALCULATION.

☑ I HEREBY CERITIFY THAT THE PROPERTY LINES AND ANY INPROVMENTS ARE CORRECT AND NO VISIBLE ENCROACHMENTS EXIST UNLESS OTHERWISE SHOWN.

☑ THIS PROPERTY IS SUBJECT TO ANY EASEMENTS OR RIGHT OF WAYS OF RECORD OR NOT OF RECORD

☑ TH IS STUR IS NOT WITHIN A FLOOD HAZARD AREA

CHARLES E. WEBB
REGISTERED
1577
LAND SURVEYOR
SOUTH CAROLINA

REF — PLAT OF RILEY ESTATES MAY 1963 BY WEBB SURVEYING

B.B.R. 242.2 - 6 - 8

THE PRINT MACHINE, INC. N56984

5.00CR