


- 3.0 AC -

Note: Improvements on this lot are not in a flood hazard area.

REF: PLAT OF PROP. OF CHARLES SMITH BY TERRY T. DILL DATED 5-21-1980.

PROPERTY OF
DAVID J. KATCHICK & DEBRA L. KATCHICK
 BATES TOWNSHIP, GREENVILLE CO., S.C.
 SCALE: 1" = 60' 20 MAY 1985

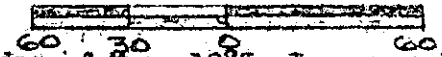

This is to certify that on the 20th day of May, 1985, I surveyed the property shown on this plat, being known as 3.0 acres on plat of PROPERTY OF CHARLES SMITH on unrecorded plat by Terry Dill, Reg. Land Surveyor and also known as PROPERTY OF DAVID J. KATCHICK & DEBRA L. KATCHICK and recorded in the RMC Office Greenville County, S. C., in Plat Book _____ at Page _____; and that the property lines, walls and buildings are as shown hereon, and that the walls and buildings located on said lot do not encroach or project on adjacent street or property, and that no adjacent walls or buildings encroach or project on said premises, and no power lines cross this property except as shown hereon.

R. B. Bruce
 R. B. Bruce, RLS # 1952

Recordable Plat

CAROLINA SURVEYING CO.
 112 Manly St.
 Greenville, S. C.

MAY 31 1985
 36546

11-N-57

FILED
 GREENVILLE CO., S.C.
 MAY 31 2 50 PM '85
 DONNIE S. JAMESLEY
 R.M.C.

MICROFILMED