
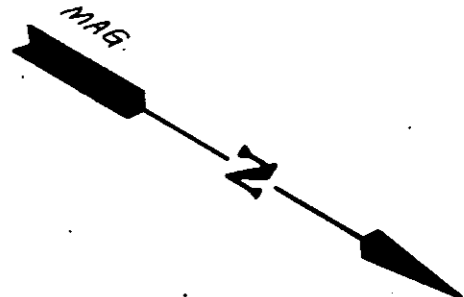


BURGESS N/F

BURGESS N/F

N 30 17 W

276.46

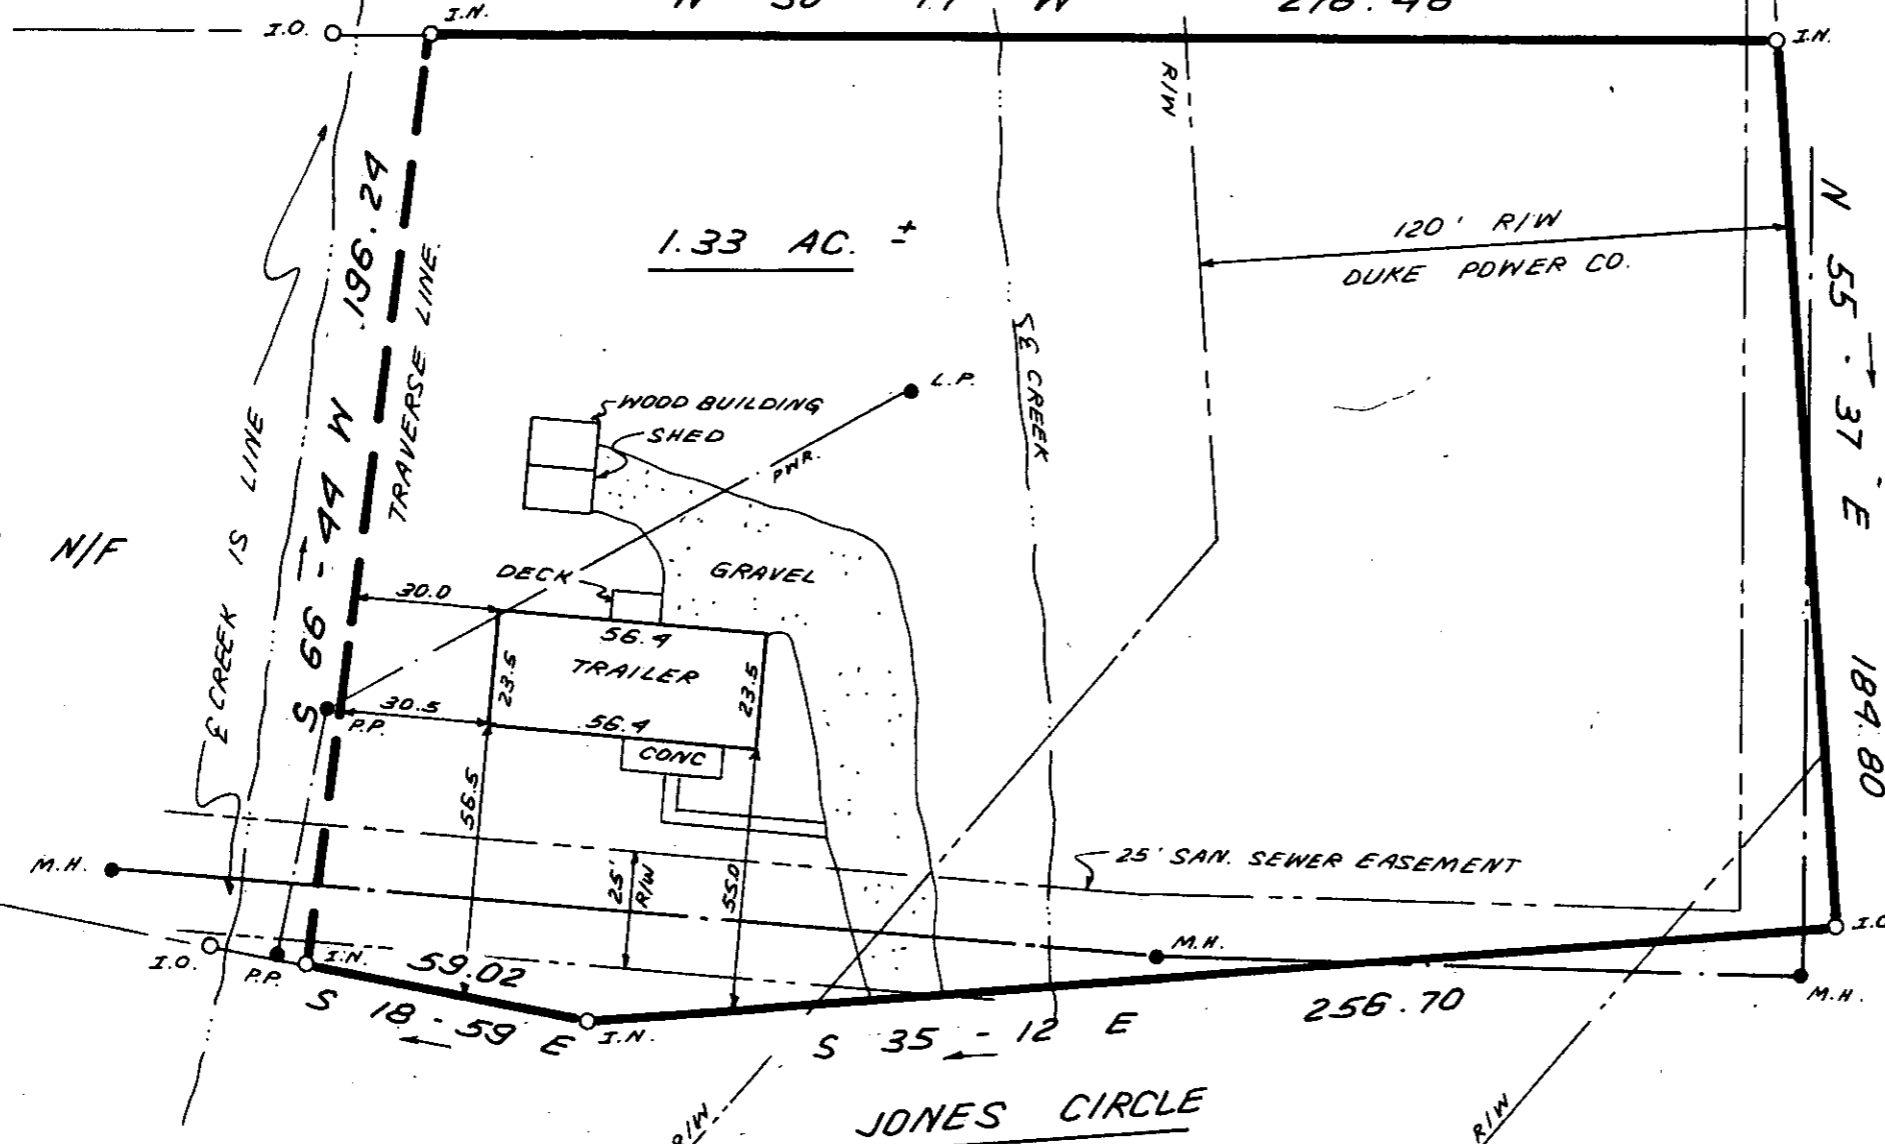

MANN N/F

NIX CIRCLE

JONES CIRCLE




FILED
GREENVILLE CO. S.C.
JUN 7 3 54 PM '85
DONNIE S. WALKERSLEY
R.M.C.

THIS IS TO CERTIFY THAT THE PROPERTY SHOWN ON THIS PLAT WAS SURVEYED UNDER MY DIRECT SUPERVISION. PROPERTY LINES AND IMPROVEMENTS SHOWN ARE LOCATED CORRECTLY AND THAT NO VISIBLE ENCROACHMENTS EXIST UNLESS OTHERWISE SHOWN. THIS PROPERTY IS LOCATED IN A DESIGNATED FLOOD HAZARD AREA.

37507

11-N-77

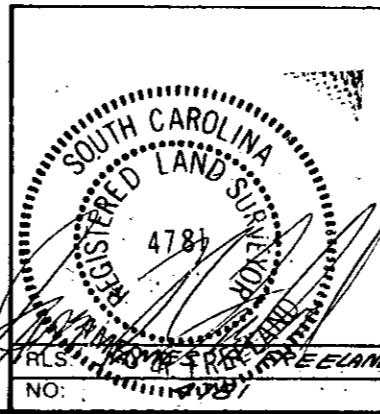

STATE OF SOUTH CAROLINA
GREENVILLE COUNTY

FREELAND & ASSOCIATES
Engineers • Land Surveyors
318 WEST STONE AVENUE.
GREENVILLE, S.C.
(803) 271-4924

SURVEY FOR
LLOYD A. TUCKER
EUNICE TUCKER

PLAT BOOK	57-46
DEED BOOK	1166-535
TAX MAP	B 9.2-1-848.2
PARTY CHIEF	L.T.
DRAWN	K.E.G.
DATE	6-6-85
DWG. NO.	13156

LARRY WOOD

MICROFILMED