


THIS IS TO CERTIFY THAT THE PROPERTY SHOWN ON THIS PLAT WAS SURVEYED UNDER MY DIRECT SUPERVISION. PROPERTY LINES AND IMPROVEMENTS SHOWN ARE LOCATED CORRECTLY AND THAT NO VISIBLE ENCROACHMENTS EXIST UNLESS OTHERWISE SHOWN. THIS PROPERTY IS NOT LOCATED IN A DESIGNATED FLOOD HAZARD AREA.

JUN 13 1985
 DONNIE S. JENNERSLEY
 JUN 13 4 21 PM '85
 GREENVILLE CO. S.C.
 FILED

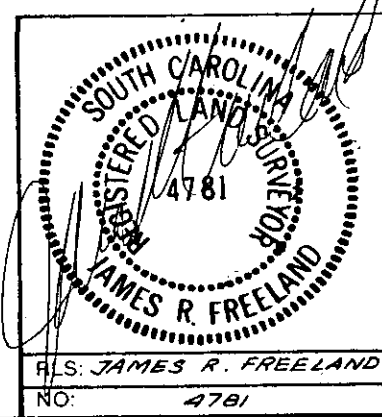

STATE OF SOUTH CAROLINA
GREENVILLE COUNTY
OVERBROOK LAND CO.
LOT 15; LOT 106
PROPERTY OF
RONALD H. CLINE, SR.
MARY C. CLINE

FREELAND & ASSOCIATES Engineers • Land Surveyors 318 WEST STONE AVENUE. GREENVILLE, S.C. (803) 271-4924	
PLAT BOOK	K-59
DEED BOOK	1057-958
TAX MAP	192-3-26
PARTY CHIEF	B.G.
DRAWN	B.A.
DATE	6-10-85
DWG. NO.	13/58

THE PRINT MACHINE, INC. NA1289

MICROFILMED