


MICROFILMED

FILED
GREENVILLE CO. S.C.
MAY 2 10 04 AM
DONNIE S. LAMAR
R.H.C.

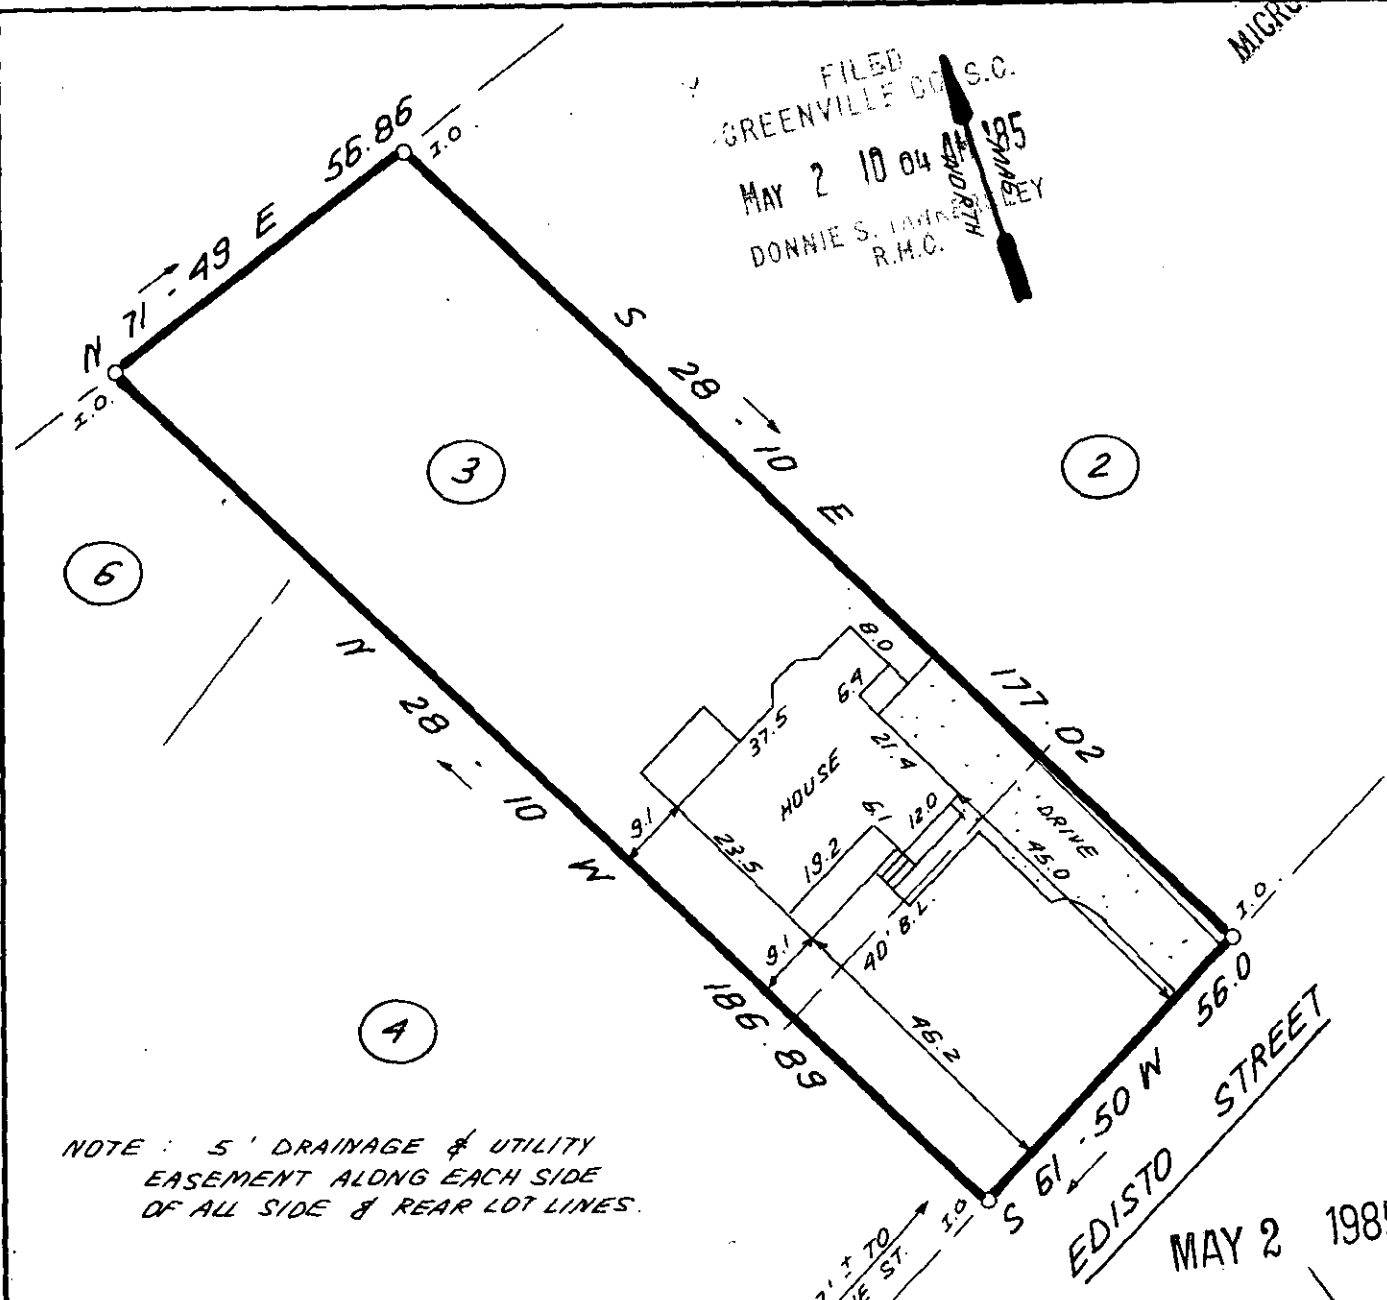

NOTE: 5' DRAINAGE & UTILITY EASEMENT ALONG EACH SIDE OF ALL SIDE & REAR LOT LINES.

30 0 30 60
SCALE: 1" = 30' FEET

MAY 2 1985
11-0-33220

THIS IS TO CERTIFY THAT THE PROPERTY SHOWN ON THIS PLAT WAS SURVEYED UNDER MY DIRECT SUPERVISION PROPERTY LINES AND IMPROVEMENTS SHOWN ARE LOCATED CORRECTLY AND THAT NO VISIBLE ENCROACHMENTS EXIST UNLESS OTHERWISE SHOWN. THIS PROPERTY IS NOT LOCATED IN A DESIGNATED FLOOD HAZARD AREA.

SOUTH CAROLINA
REGISTERED LAND SURVEYOR
JAMES R. FREELAND
NO. 4781

STATE OF SOUTH CAROLINA
GREENVILLE COUNTY

EDISTO FOREST
LOT 3
PROPERTY OF
DONALD G. PICK, JR.
LOIS ANN PICK

FREELAND & ASSOCIATES
Engineers • Land Surveyors
318 WEST STONE AVENUE.
GREENVILLE, S.C.
(803) 271-4924

PLAT BOOK	9FC 34
DEED BOOK	1197@ 159
TAX MAP	221 - 1 - 181
PARTY CHIEF	J.C.C.
DRAWN	K.E.G
DATE	5-1-85
DWG NO.	12929