


Note:
Improvements
on this lot are
not in a flood
hazard area.

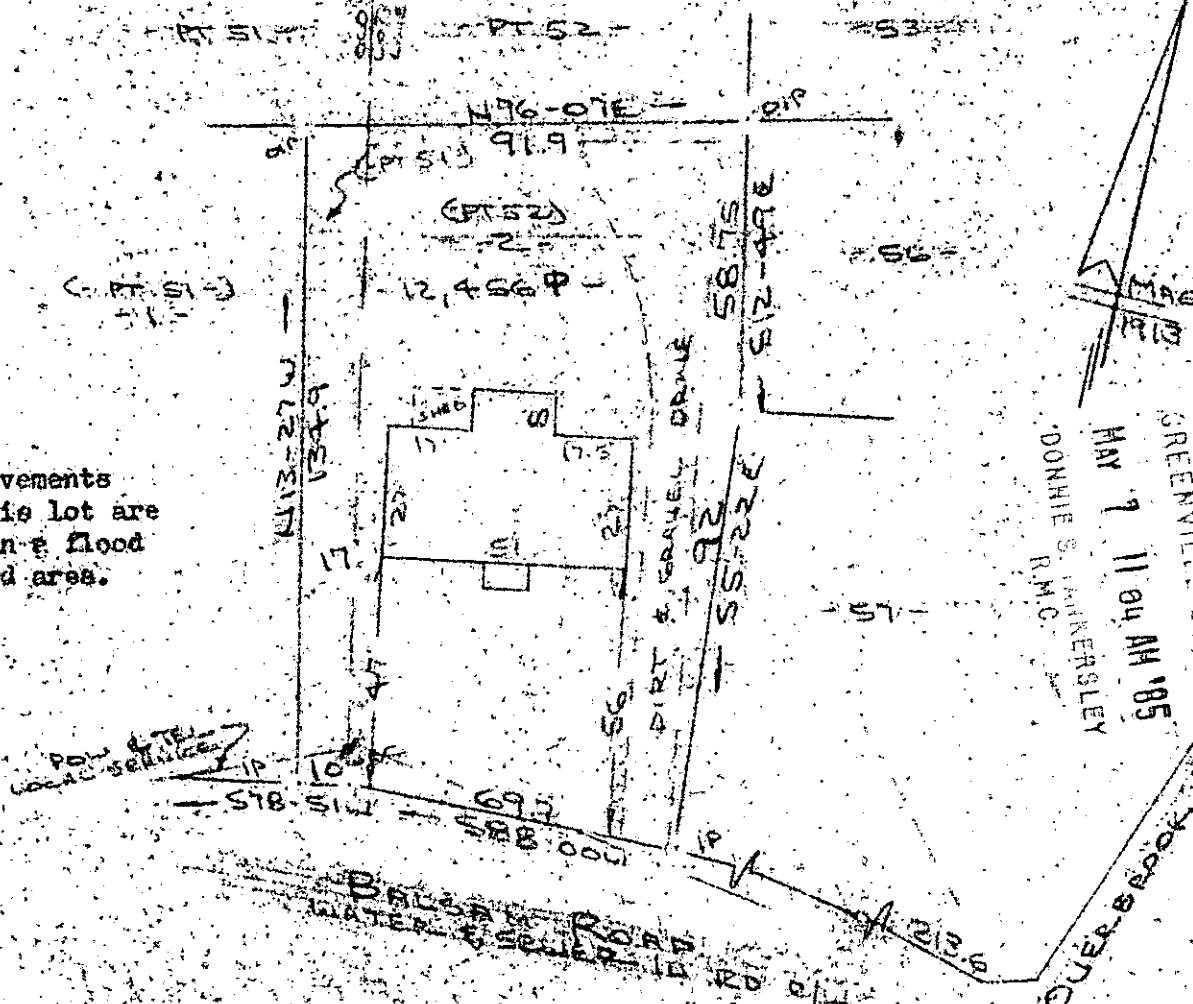

PROPERTY OF
MAYHEW BELL
SCALE 1:20 | MAY 1985

This is to certify that on the 1st day of May, 1985, I surveyed the property shown on this plat, being known as lot 2 (part of lot 52) on plat of REVISION OF LOTS 56 & 57 EVERBROOK ROAD and recorded in the RHC Office Greenville County, S. C., in Plat Book " DD " at Page 169; and also known as PROPERTY OF MAYHEW BELL and recorded in Plat Book , at Page ; and that the property lines, walls and buildings are as shown hereon, and that the walls and buildings located on said lot do not encroach or project on adjacent street or property, and that no adjacent walls or buildings encroach or project on said premises, and no power lines cross this property except as shown hereon.

11-0-21

38652

R. B. Brule

R. B. Bruce, RIS # 1952

MAY 7 1985

CAROLINA SURVEYING CO.
112 Manly St.
Greenville, S. C.