



Note:
Improvements on
this lot are not in
a flood hazard area.

Water & Sewer Lines

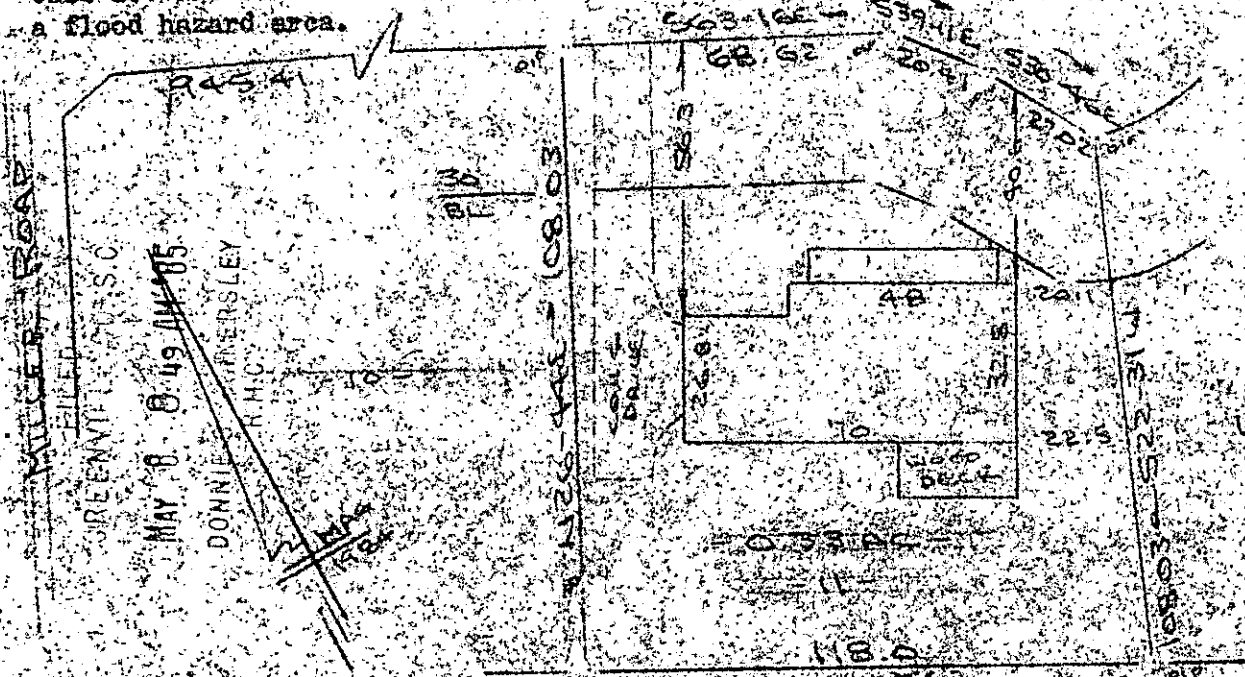

Note:
5' drainage &
utility easement along each
side of all side and rear
lot lines.

PROPERTY OF
PAUL J. HELLASER & PAUL J. HELLASER
MARLIN S.C.
SCALE 1" = 40' & MAY 1985

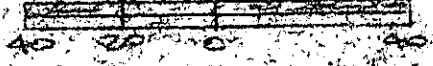

This is to certify that on the 6th day of May, 1985, I surveyed the property shown on this plat, being known as lot 11 (0.35 acre) on plat of FORRESTER FARMS and recorded in the RMC Office Greenville County, S. C., in Plat Book # 10 - N # at Page 55; and that the property lines, walls and buildings are as shown hereon, and that the walls and buildings located on said lot do not encroach or project on adjacent street or property, and that no adjacent walls or buildings encroach or project on said premises, and no power lines cross this property except as shown hereon.

11-0-25

33848

R. B. Bruce

MAY 8 1985

R. B. Bruce, SLS # 1952

CAROLINA SURVEYING CO.
112 Manly St.
Greenville, S. C.

Recordable Plat