MICROFILMED

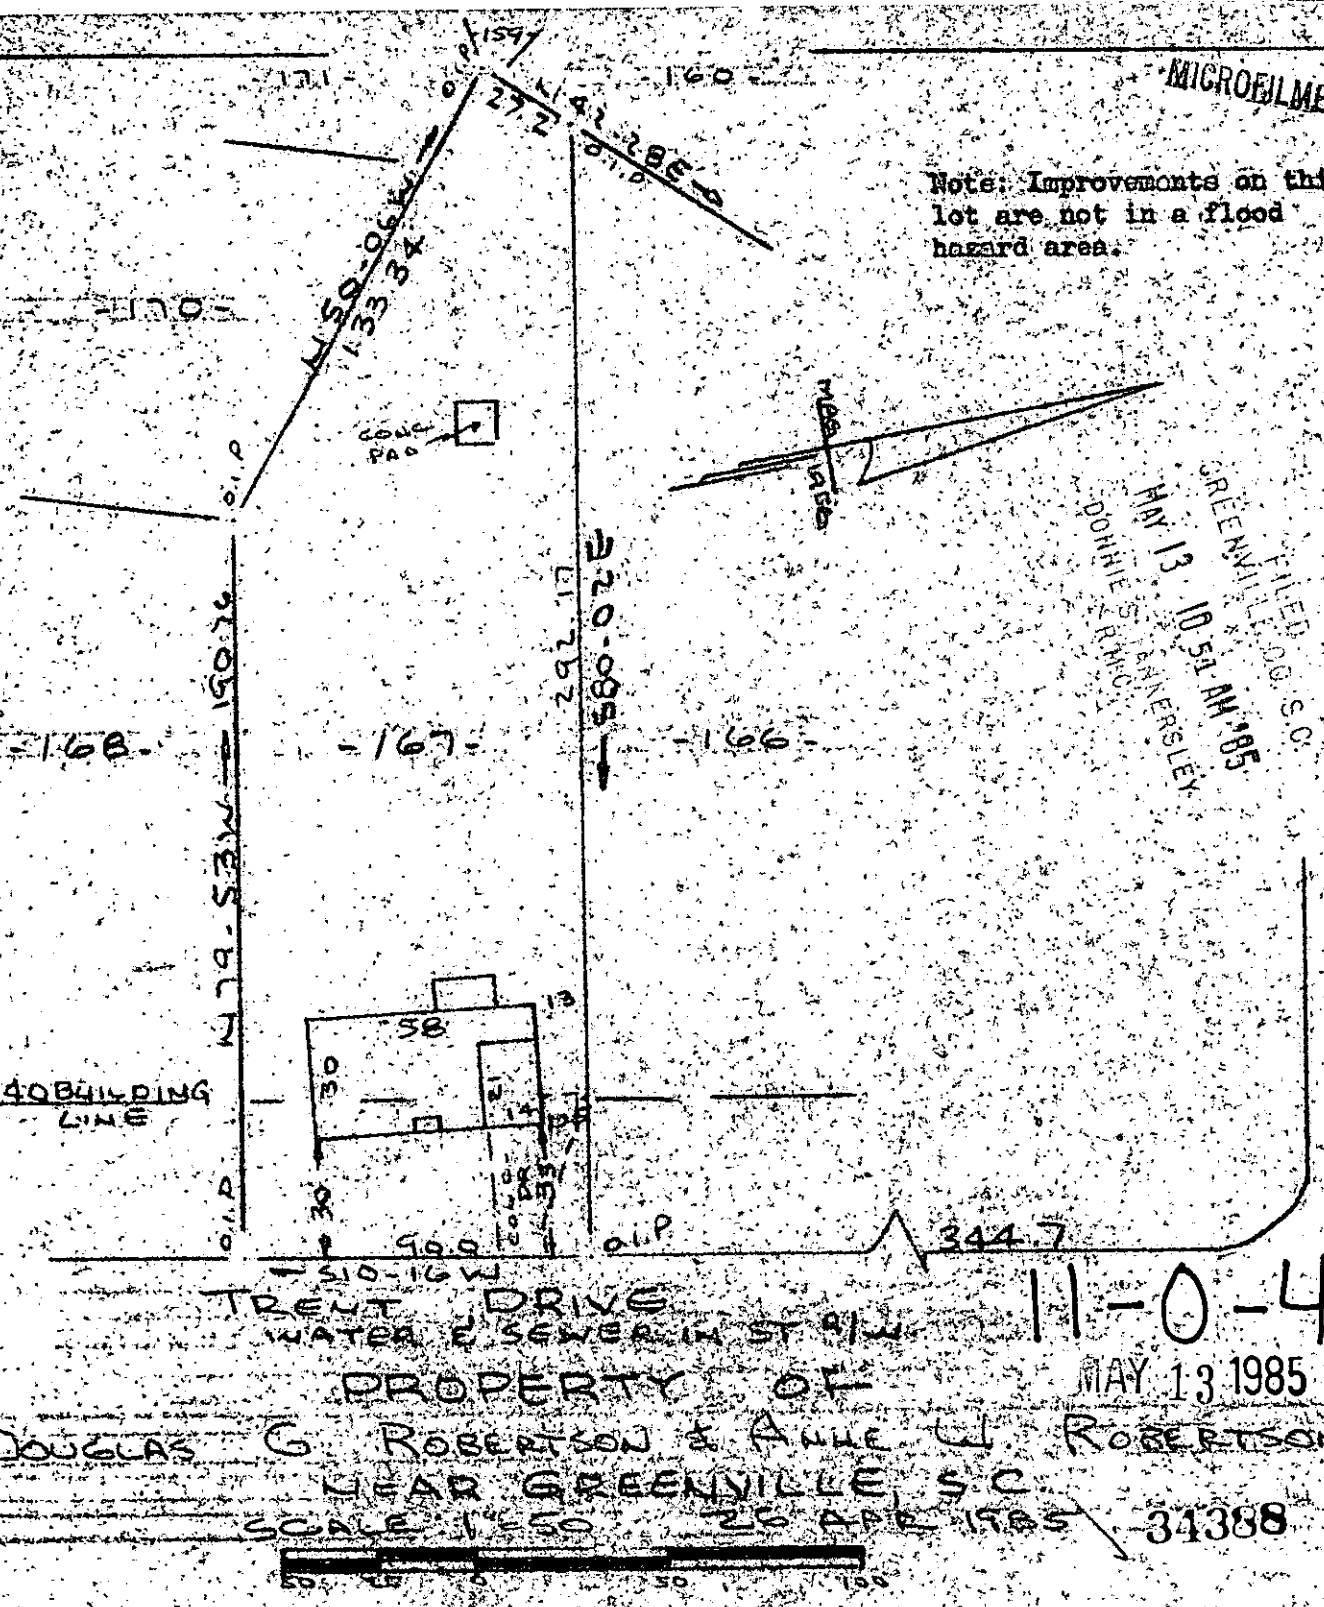

This is to certify that on the 26th day of April, 1985, I surveyed the property shown on this plat, being known as lot 167 on plat of AVEN PARK and recorded in the RMC Office Greenville County, S. C., in Plat Book " KK " at Page 71 and also being known as PROPERTY OF DOUGLAS G. ROBERTSON & ANNE U. ROBERTSON and recorded in Plat Book at Page ; and that the property lines, walls and buildings are as shown hereon, and that the walls and buildings located on said lot do not encroach or project on adjacent street or property, and that no adjacent walls or buildings encroach or project on said premises, and no power lines cross this property except as shown hereon.

R. E. Bruce

R. E. Bruce, RLS #1952

CAROLINA SURVEYING CO.
112 Manly St.
Greenville, S. C.

MAY 13 85 062

Recordable Plat

242/65A 240/65 T 33-3-204 166