


FILED
GREENVILLE, S.C.

MAY 15 3 06 PM '85

DONNIE S. TALKERSLEY
R.M.C.

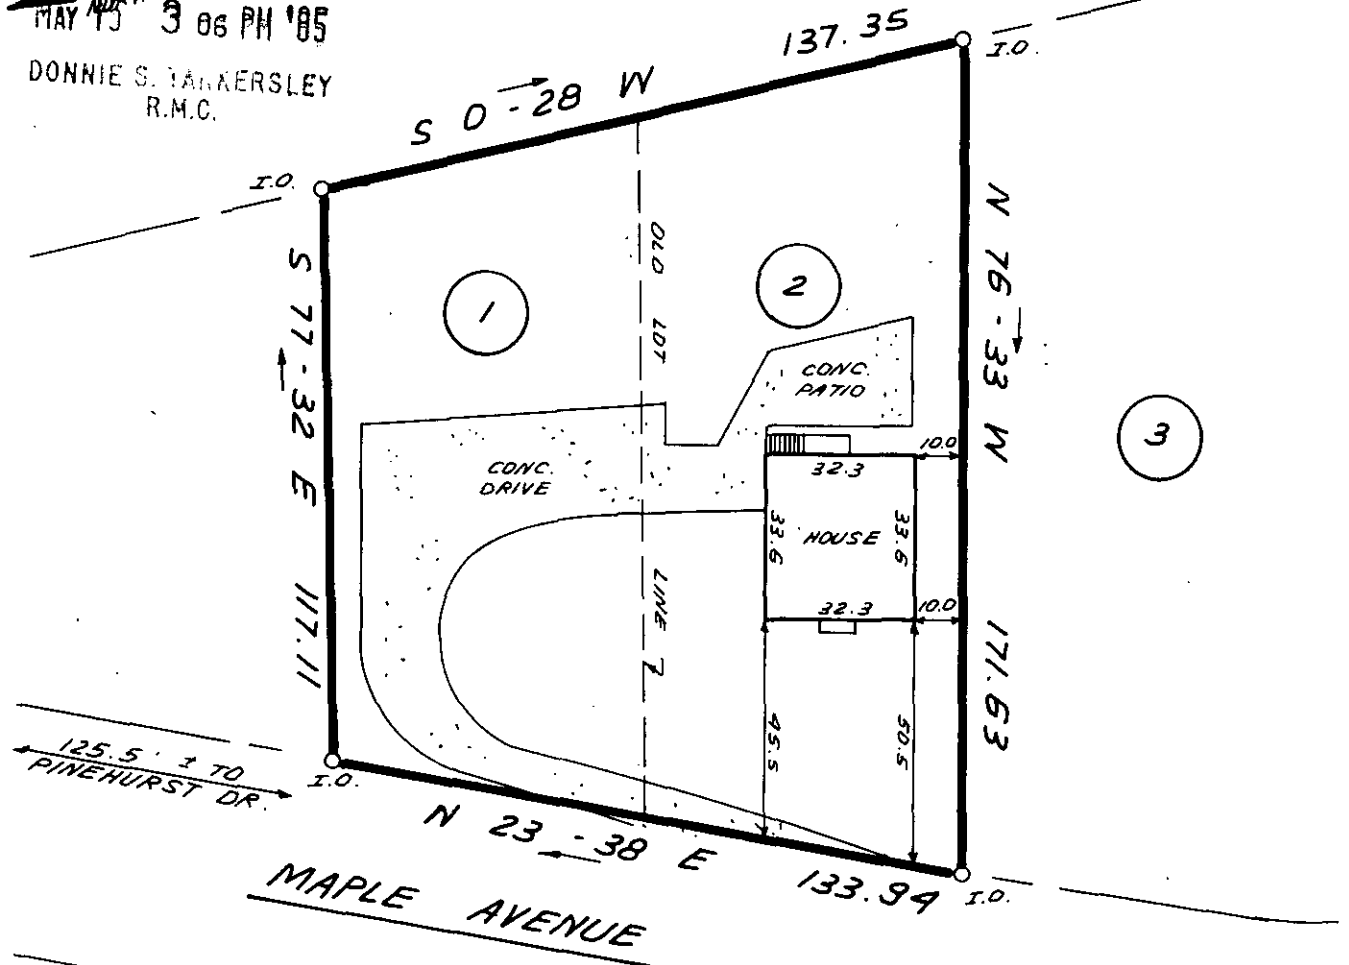

MAY 15 1985 34637

THIS IS TO CERTIFY THAT THE PROPERTY SHOWN ON THIS PLAT WAS SURVEYED UNDER MY DIRECT SUPERVISION PROPERTY LINES AND IMPROVEMENTS SHOWN ARE LOCATED CORRECTLY AND THAT NO VISIBLE ENCROACHMENTS EXIST UNLESS OTHERWISE SHOWN. THIS PROPERTY IS NOT LOCATED IN A DESIGNATED FLOOD HAZARD AREA

**STATE OF SOUTH CAROLINA
GREENVILLE COUNTY**

FREELAND & ASSOCIATES
Engineers • Land Surveyors
318 WEST STONE AVENUE.
GREENVILLE, S.C.
(803) 271-4924



UTOPIAN DEV. CO.
BLOCK K, LOTS 1&2
PROPERTY OF
SMITH C. McDONALD
HULDA H. McDONALD

PLAT BOOK	M 13 # 2 @ 69
DEED BOOK	423 - 42
TAX MAP	
PARTY CHIEF	R.A.J.
DRAWN	K.E.G
DATE	MAY 14, 1985
DWG NO.	12996

2 MAY 15 85 1233