


MICROFILMED

FILED  
GREENVILLE CO. S.C.  
MAY 17 8 56 AM '85  
DONNIE S. JAKKERSLEY  
R.M.C.

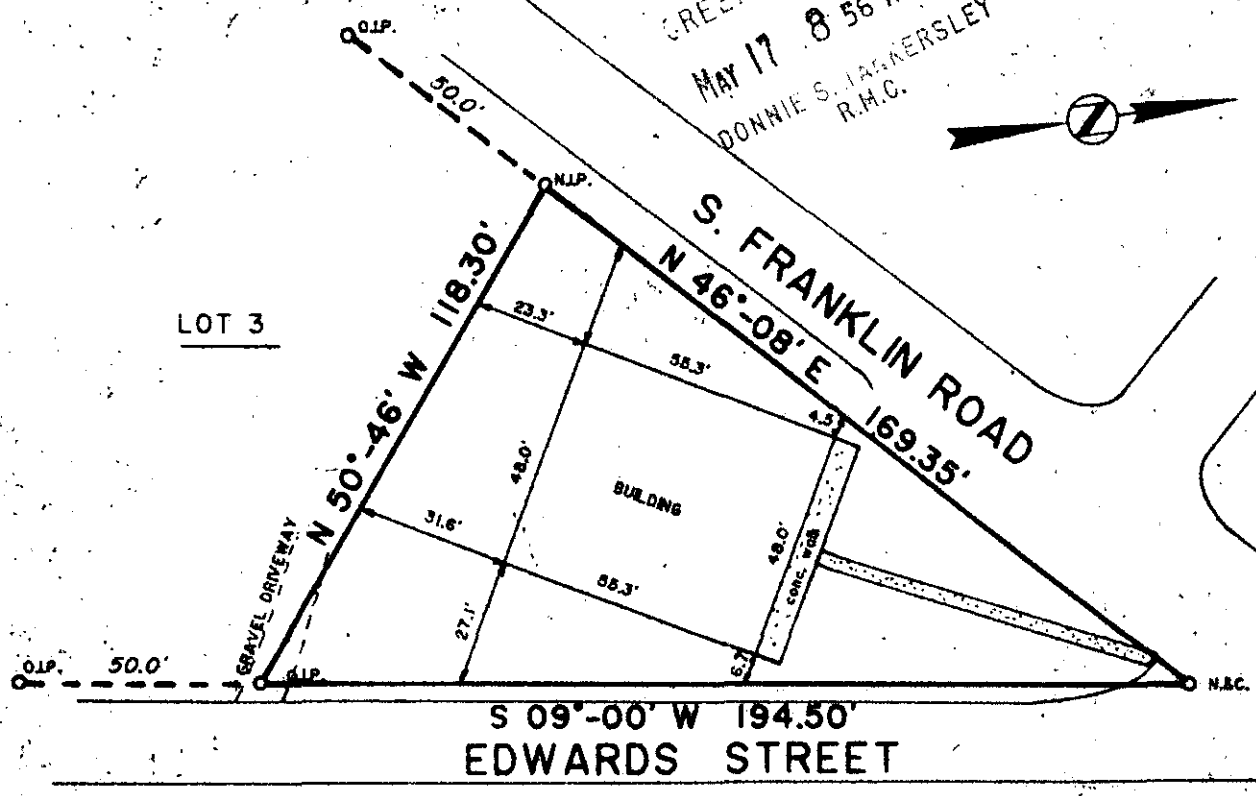

This is to certify that on May 9, 1985, I surveyed the property shown on this plat, known as Lots 1 & 2 of the John Calogeras Property, recorded in the R.M.C. Office of Greenville County in Plat Book E on Page 267, and that the property lines, walls and buildings are as shown hereon; that the building located on said lot does not encroach or project on adjacent streets or property, and that no adjacent walls or buildings encroach or project on said premises, and that no utility lines cross this property except as shown. This property is not located in a Designated Flood Hazard Area.

*Frederick E. Landrith*  
 Frederick E. Landrith, R.L.S. 9545  
 REGISTERED LAND SURVEYOR  
 STATE OF SOUTH CAROLINA


MAY 17 1985

11-0-57

34960

**LANDRITH SURVEYING**  
 Land Surveys • Topographical Maps  
 Construction Layout

4416 WHITE HORSE ROAD  
 GREENVILLE, SOUTH CAROLINA

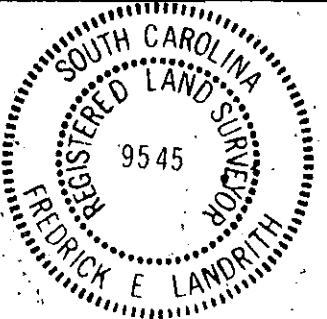

STATE of SOUTH CAROLINA  
 COUNTY of GREENVILLE

JOHN CALOGERAS PROP.  
 LOTS 1 & 2  
 SURVEY FOR

ABC HEATING & COOLING, INC.

SURVEYED BY: FEL  
 CK'D BY: FEL  
 DRAWN BY: FEL  
 DATE: 5/9/85

SEAL

PROJECT NO. 85-261  
 300 8 21801