MICROFILMED

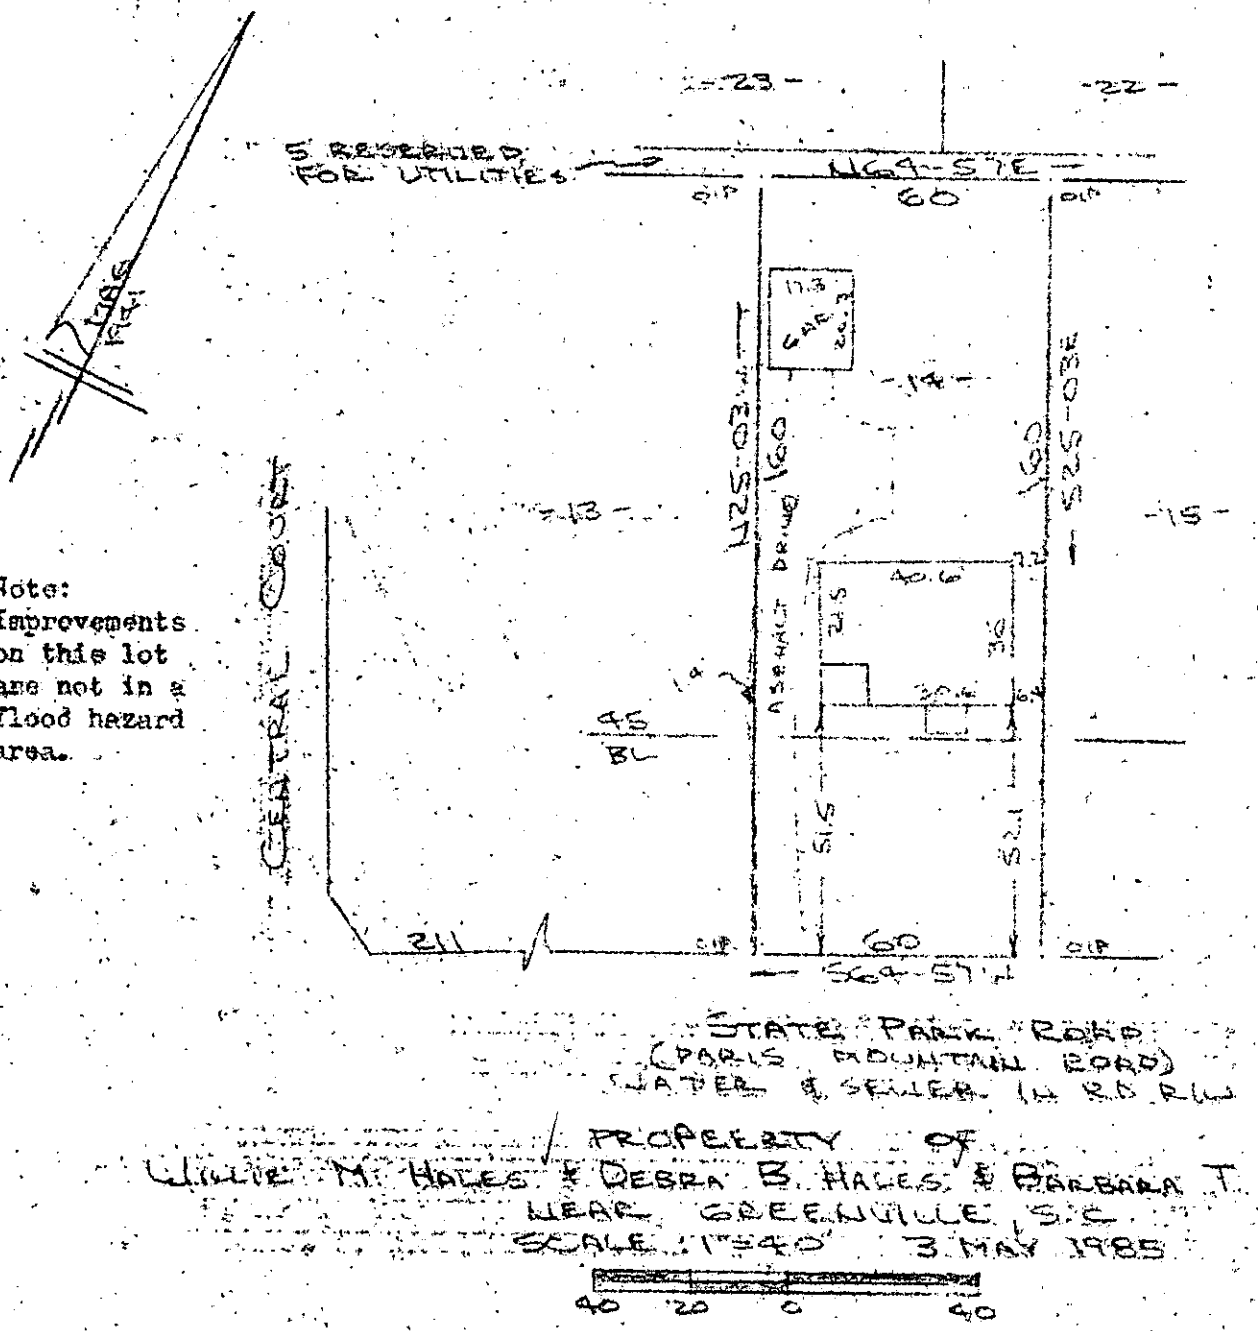

Note: Improvements on this lot are not in a flood hazard area.

This is to certify that on the 3rd day of May, 1985, I surveyed the property shown on this plat, being known as lot 14 on plat of NORTH SUNSET HILLS and recorded in the RMC Office Greenville County, S. C., in Plat Book " I " at Page 92; and that the property lines, walls and buildings are as shown hereon, and that the walls and buildings located on said lot do not encroach orproject on adjacent street or property, and that no adjacent walls or buildings encroach or project on said premises, and no power lines cross this property except as shown hereon.

11-0-65 35166

R. B. Bruce

R. B. Bruce, RLS # 1952

DONNIE S. TALKERSLEY
R.M.C.

MAY 20 3 35 PM '85

FILED

CAROLINA SURVEYING CO.
112 Manly St.
Greenville, S. C.

Recordable Plat

-2 MY20 85 1579

3.00CI

285/55A