


GREENVILLE S.C.
 MAY 22 9:02 AM '85
 DONNIE'S R.M.C.
 WATERSLEY

PROPERTY OF
 DENNIS S. SOUTHERN & CONNIE L. SOUTHERN
 NEAR GREENVILLE, S.C.
 SCALE: 1" = 50' 23 APR 1985

MAY 22 1985

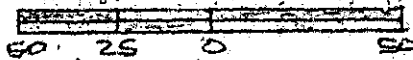

11-0-69

This is to certify that on the 23rd day of April, 1985, I surveyed the property shown on this plat, being known as lot 66 on plat of CHICK SPRINGS SECTION #3 and recorded in the RMC Office Greenville County, S.C., in Plat Book "UUU" at Page 91B, that the property lines, walls and buildings are as shown hereon, and that the walls and buildings located on said lot do not encroach or project on adjacent street or property, and that no adjacent walls or buildings encroach or project on said premises, and no power lines cross this property except as shown hereon.

35457

R. B. Bruce
R. B. Bruce
 R. B. Bruce, RLS #1952

Recordable Plat
 BRUC

CAROLINA SURVEYING CO.
 112 Manly St.
 Greenville, S. C.

MAY 22 85 1301 3:00 P