


Note: Improvements on this lot are not in a flood hazard area.

Note: Drainage & utilities easement 5' each side of side and rear lot lines.

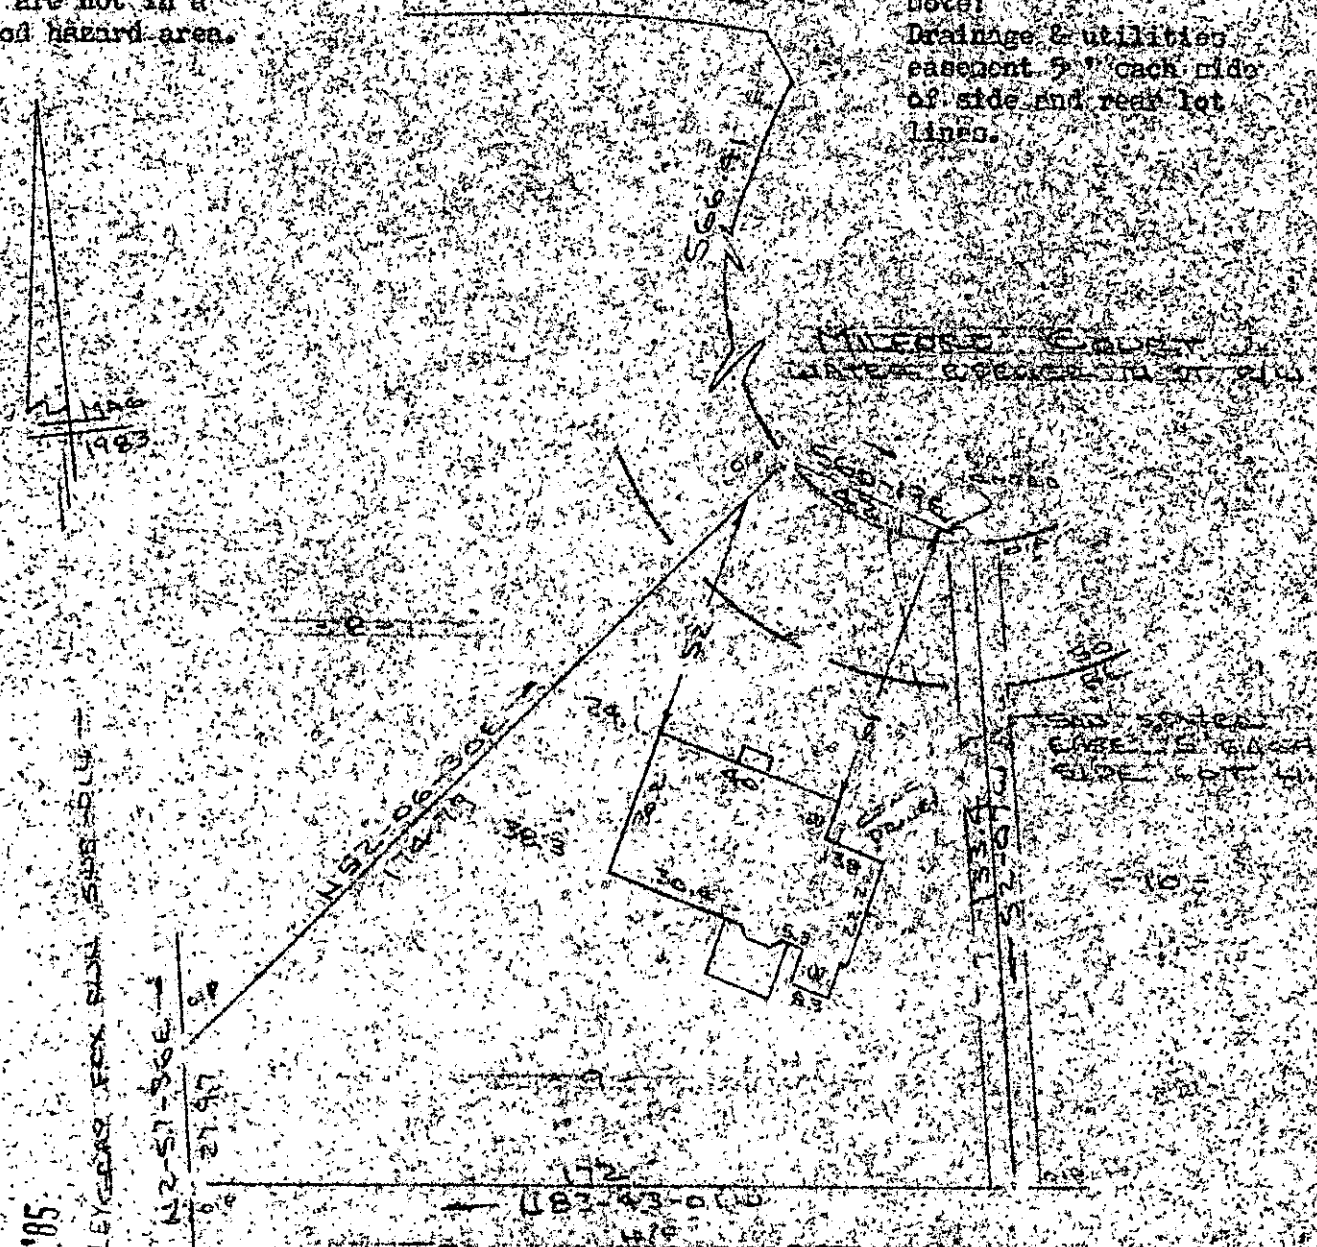

FILED
 REENVILLE CO. S.C.
 MAY 22 11 41 AM '85
 DONNIE S. B. WILSON
 RECORDER

PROPERTY OF
 ROBERT P. FOSTER & KIMBERLY C. FOSTER
 BEING GREENVILLE GREENVILLE CO. S.C.
 SURVEYED BY W. MAY 1985



This is to certify that on the 8th day of May, 1985, I surveyed the property shown on this plat, being known as lot 9 on plat of RUSSTON PLACE and recorded in the REC Office Greenville County, S. C., in Plat Book 79 - 4-9 at Page 75; and that the property lines, walls and buildings are as shown hereon, and that the walls and buildings located on said lot do not encroach or project on adjacent street or property, and that no adjacent walls or buildings encroach or project on said premises, and no power lines cross this property except as shown hereon.

11-0-73 35456 ✓
 CAROLINA SURVEYING CO.
 112 Manly St.
 Greenville, S. C.
 R. B. Bruce, RLS # 152
 Recordable Plat