


Note: Improvements on this lot are not in a flood hazard area.

PROPERTY OF  
 JOHN C. PORTER & JEAN D. PORTER  
 NEAR GREENVILLE, S.C.  
 SCALE 1"=40' 22 APR 1985

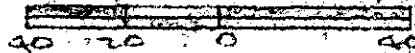

This is to certify that on the 22nd day of April, 1985, I surveyed the property shown on this plat, being known as lot 12 on plat of PROPERTY OF TALMER CORDELL & JAMES H. CAMPBELL and recorded in the BMC Office Greenville County, S. C., in Plat Book "Z" at Page 175; and that the property lines, walls and buildings are as shown hereon, and that the walls and buildings located on said lot do not encroach or project on adjacent street or property, and that no adjacent walls or buildings encroach or project on said premisses, and no power lines cross this property except as shown hereon.

11-0-90 35811

*R. B. Bruce*

R. B. Bruce, RLS # 1952

CAROLINA SURVEYING MY24 85. 079  
 112 Manly St.  
 Greenville, S. C.

3.0000  
 Recordable Plat

FILED  
 GREENVILLE, S.C.  
 MAY 24 4 26 PM 1985  
 DONNIE S. RHOLES  
 CLERK