




GREENVILLE CO. S.C.
MAY 28 11 05 AM '85
DONNIE S. WILKINSON
R.H.C.

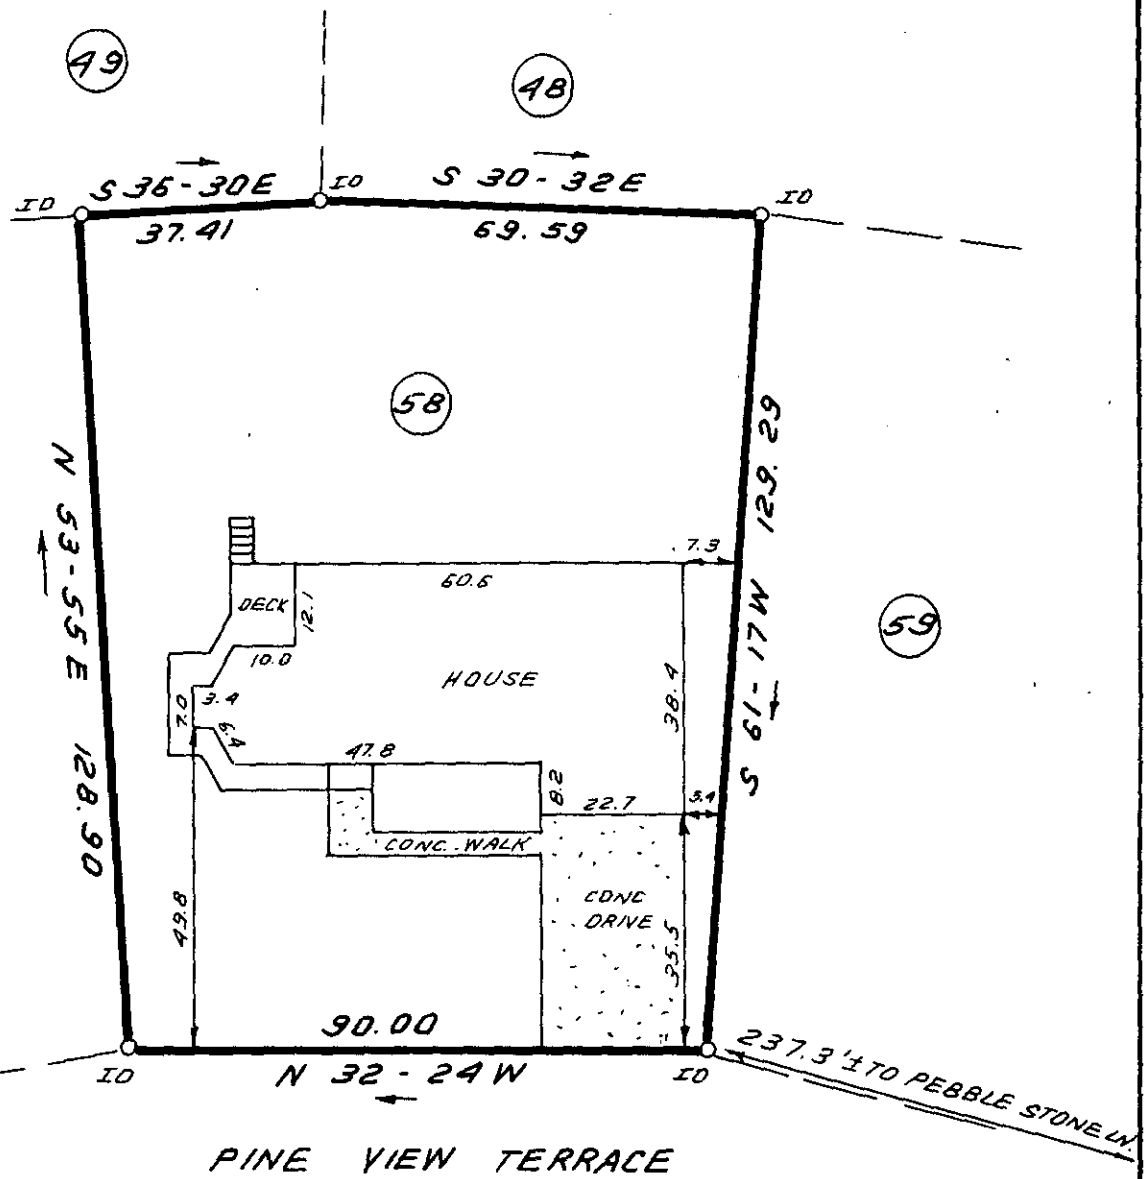

NOTE:
5' DRAINAGE & UTILITY
EASEMENT ALONG ALL
SIDE & REAR LOT LINES


PINE VIEW TERRACE

MAY 28 1985



35995 ✓ 11-0-91

THIS IS TO CERTIFY THAT THE PROPERTY SHOWN ON THIS PLAT WAS SURVEYED UNDER MY DIRECT SUPERVISION PROPERTY LINES AND IMPROVEMENTS SHOWN ARE LOCATED CORRECTLY AND THAT NO VISIBLE ENCROACHMENTS EXIST UNLESS OTHERWISE SHOWN. THIS PROPERTY IS NOT LOCATED IN A DESIGNATED FLOOD HAZARD AREA.

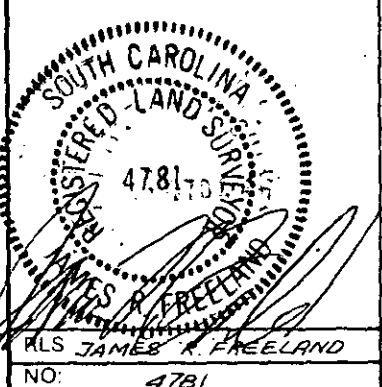

**STATE OF SOUTH CAROLINA
GREENVILLE COUNTY**

PEBBLE CREEK
PHASE IV, SEC. II, LOT 58
PROPERTY OF
JANDS P. KOVACS
KLARA KOVACS

FREELAND & ASSOCIATES
Engineers • Land Surveyors
318 WEST STONE AVENUE,
GREENVILLE, S.C.
(803) 271-4924

PLAT BOOK
DEED BOOK 1136-232
TAX MAP 7C-47
PARTY CHIEF J.C.C.
DRAWN B.R.
DATE 5-23-85
DWG NO. 13050