

MICROFILMED



COMMON AREA

N 13° - 09' E

16.0'

6.2'

6.0'

UNIT 14

UNIT 13

UNIT 12

FILED
GREENVILLE, S.C.
MAY 30 11:22 AM '85
DONNIE S. WAINWRIGHT
R.M.C.

N 76° - 51' W

30.12'

36.22'

S 76° - 51' E

22.0'


S 13° - 09' W

COMMON AREA

This is to certify that on May 28, 1985, I surveyed the property shown on this plat, known as Unit 13, on plat of Furman Place Phase One, recorded in the R.M.C. Office of Greenville County in Plat 11-I on Page 30, and that the property lines, walls and buildings area as shown hereon, that the building located on said lot does not encroach or project on adjacent streets or property, and that no adjacent walls or buildings encroach or project on said premises, and that no utility lines R/W's cross this property except as shown hereon. This property is not located in a Designated Flood Hazard Area.

11-Q-9 36239
MAY 30 1985

Fredrick E. Landrith
Fredrick E. Landrith S.L.S. 9545

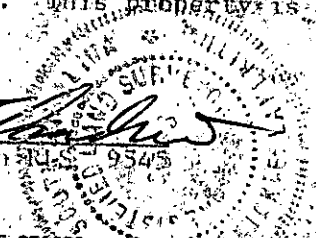


THIS PROPERTY IS SUBJECT TO ANY AND ALL RIGHTS OF WAY AND EASEMENTS OF RECORD.

LANDRITH SURVEYING
Land Surveys • Topographical Maps
Construction Layout

4416 WHITE HORSE ROAD
GREENVILLE, SOUTH CAROLINA

40 0 40

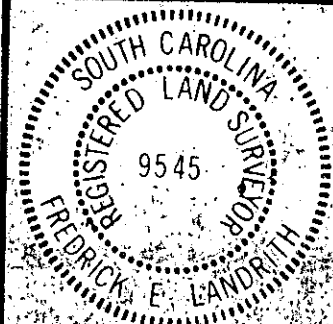

STATE of SOUTH CAROLINA
COUNTY of GREENVILLE

PHASE ONE
FURMAN PLACE
UNIT 13

PROPERTY OF
ROBERT B. McCRARY
CAROL J. McCRARY

SURVEYED BY FEL CK'D BY FEL

DRAWN BY FEL DATE 5/28/85

SEAL

PROJECT NO. 85-278