MICROFILMED

FILED
GREENVILLE CO. S.C.
MAY 31 11 10 AM '85
DONNIE S. TANKERSLEY
R.M.C.

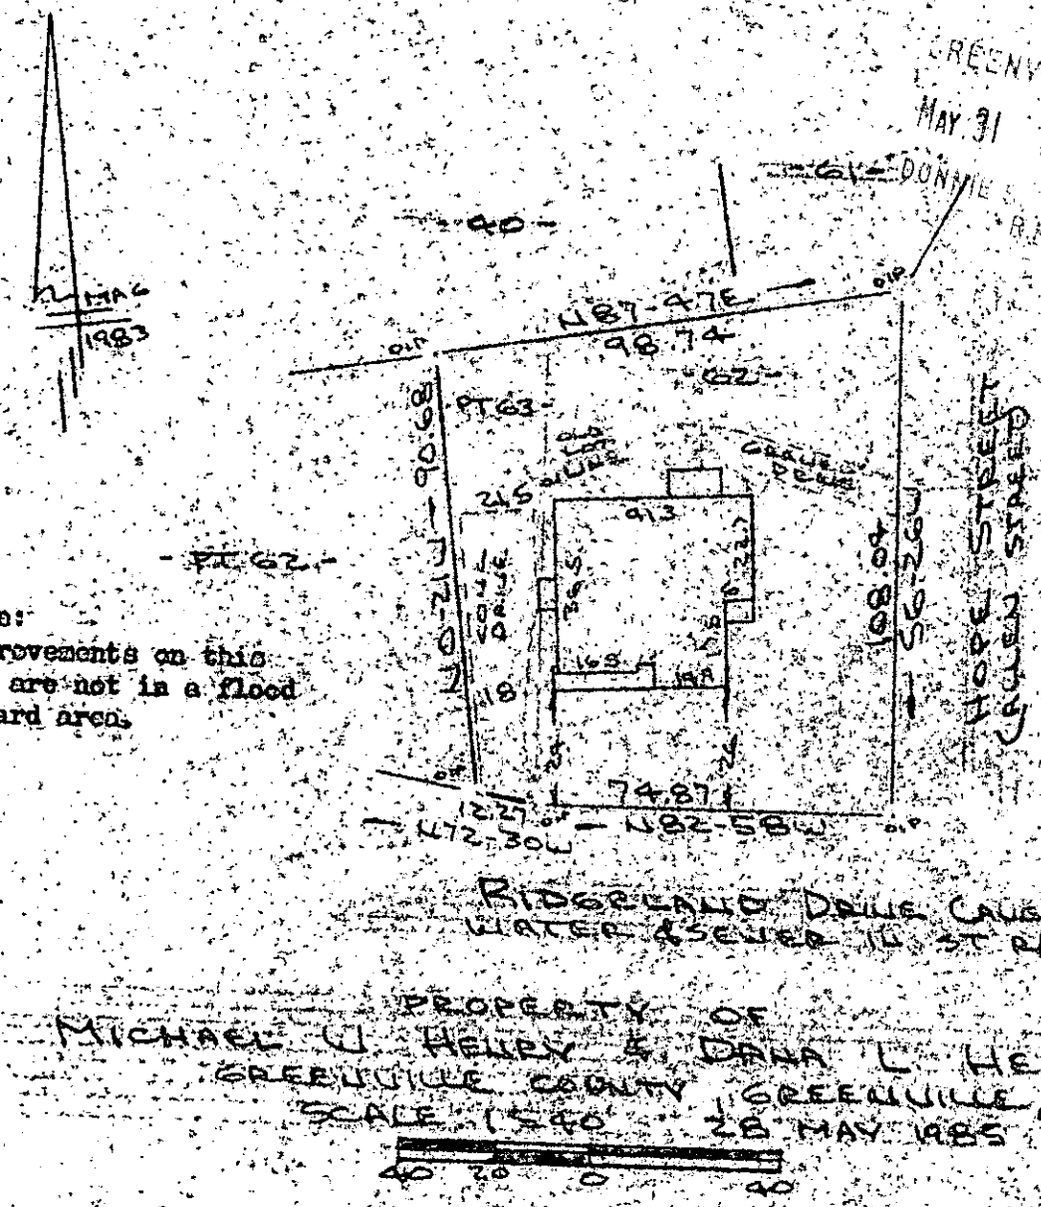


This is to certify that on the 28th day of May, 1985, I surveyed the property shown on this plat, being known as lot 62 and part of lot 63 on plat of CLEVELAND TERRACE and recorded in the RMC Office Greenville County, S. C., in Plat Book " H " at Page 143; and that the property lines, walls and buildings are as shown hereon, and that the walls and buildings located on said lot do not encroach or project on adjacent street or property, and that no adjacent walls or buildings encroach or project on said premises, and no power lines cross this property except as shown hereon.

36537

11-2-22

R. B. Bruce

R. B. Bruce, RLS # 1952

Recordable Plat

CAROLINA SURVEYING CO.
113 Manly St.
Greenville, S. C.

287/38A

68-2-123