


MICROFILMED

FILED
GREENVILLE CO. S.C.
JUN 3 10 59 AM '85
DONNIE S. LARKER
R.M.C.
WABSWORTH

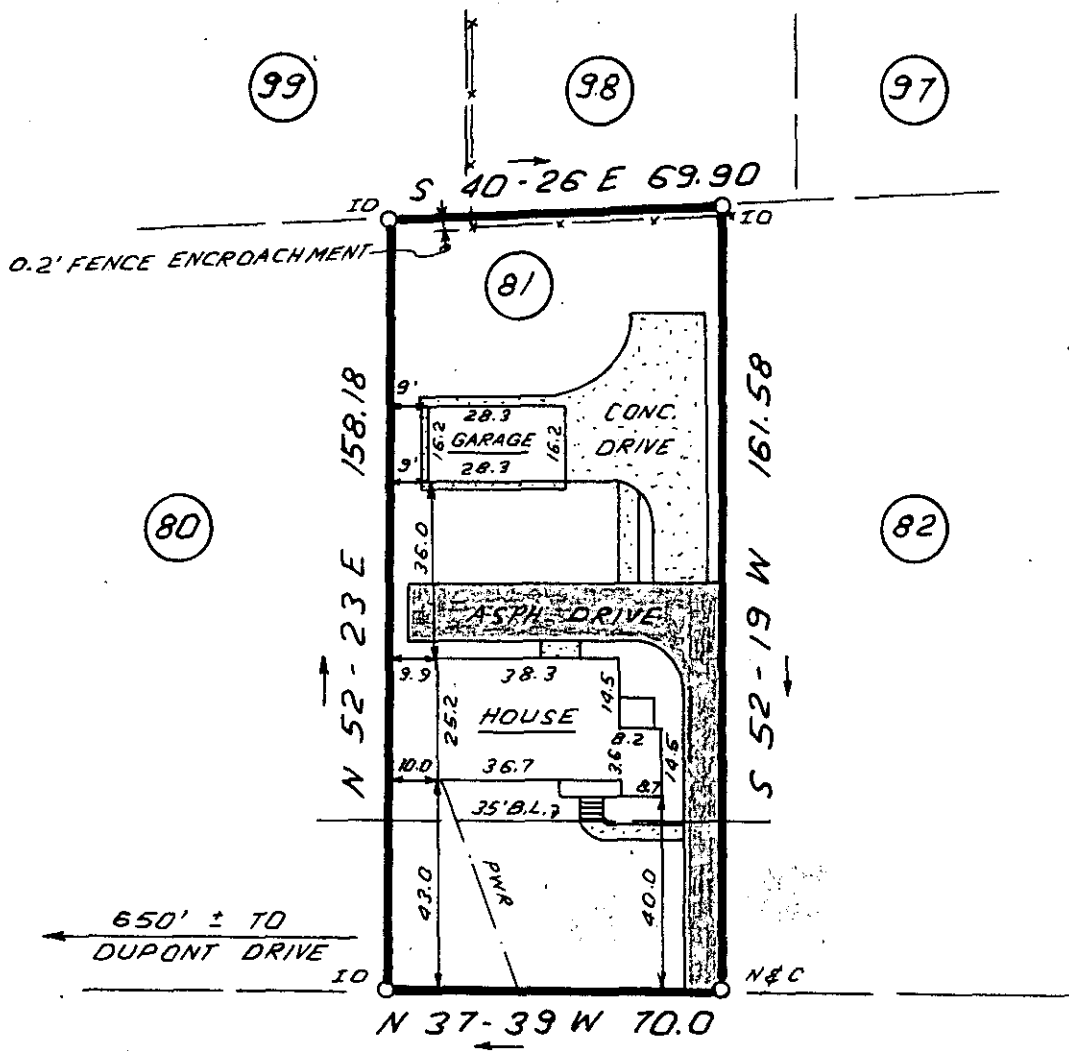

HARRINGTON AVENUE

JUN 3 1985

11Q-33 36791



THIS IS TO CERTIFY THAT THE PROPERTY SHOWN ON THIS PLAT WAS SURVEYED UNDER MY DIRECT SUPERVISION. PROPERTY LINES AND IMPROVEMENTS SHOWN ARE LOCATED CORRECTLY AND THAT NO VISIBLE ENCROACHMENTS EXIST UNLESS OTHERWISE SHOWN. THIS PROPERTY IS NOT LOCATED IN A DESIGNATED FLOOD HAZARD AREA

**STATE OF SOUTH CAROLINA
GREENVILLE COUNTY**

FREELAND & ASSOCIATES
Engineers • Land Surveyors
318 WEST STONE AVENUE.
GREENVILLE, S.C.
(803) 271-4924

ISAUQUEENA PARK
LOT 81
PROPERTY OF
TIMOTHY D. Mc GEE ✓
MONICA J. MILLER ✓

PLAT BOOK	P-131
DEED BOOK	1124-506
TAX MAP	189.3-6-16
PARTY CHIEF	J.E.C.
DRAWN	I.R.
DATE	5-30-85
DWG NO.	13118

SOUTH CAROLINA
REGISTERED LAND SURVEYOR
4781
JAMES R. FREELAND
R.L.S. JAMES R. FREELAND
NO: 4781

2 JUN 3 95 1221 3.00