


(168-3-6A)

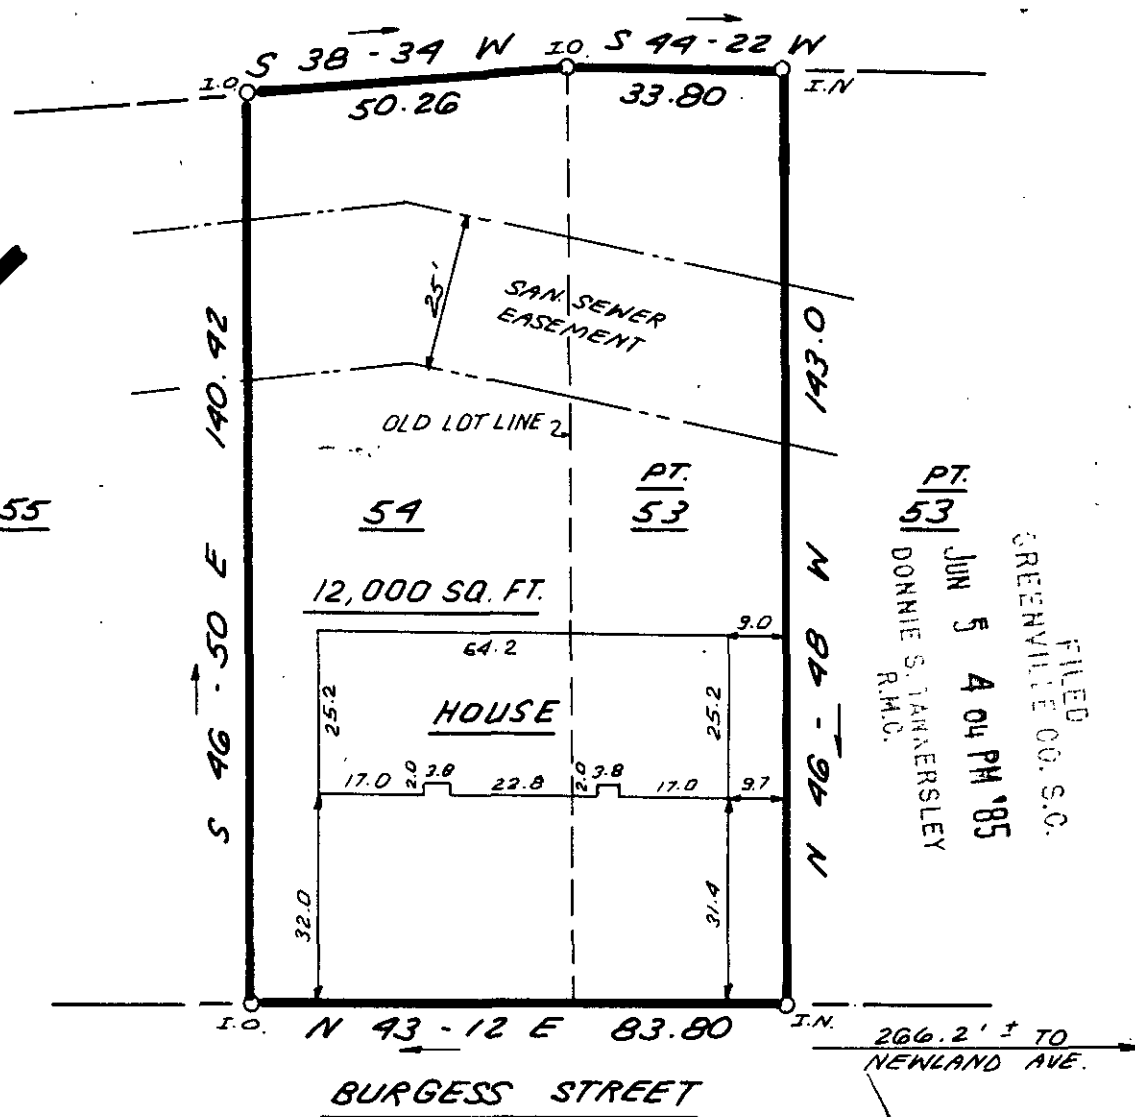

55




FILED
 GREENVILLE CO. S.C.
 JUN 5 4 04 PM '85
 DONNIE S. JANKERSLEY
 R.M.C.



11-Q-57 JUN 5 1985

37162

THIS IS TO CERTIFY THAT THE PROPERTY SHOWN ON THIS PLAT WAS SURVEYED UNDER MY DIRECT SUPERVISION. PROPERTY LINES AND IMPROVEMENTS SHOWN ARE LOCATED CORRECTLY AND THAT NO VISIBLE ENCROACHMENTS EXIST UNLESS OTHERWISE SHOWN. THIS PROPERTY IS NOT LOCATED IN A DESIGNATED FLOOD HAZARD AREA.

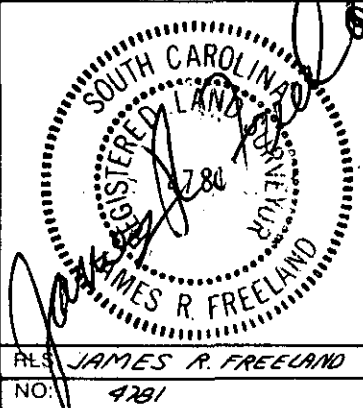

**STATE OF SOUTH CAROLINA
 GREENVILLE COUNTY**

NEWLANDS
SEC 1; LOT 54; PT. 53
PROPERTY OF
JEROME P. CARNE
JONATHAN W. BRUSH

FREELAND & ASSOCIATES Engineers • Land Surveyors 318 WEST STONE AVENUE, GREENVILLE, S.C. (803) 271-4924	
PLAT BOOK	C-199
DEED BOOK	
TAX MAP	
PARTY CHIEF	L.T.
DRAWN	K.E.G.
DATE	6-4-85
DWG. NO.	13142