


FILED
GREENVILLE CO. S.C.
JUN 7 12 49 PM '85
DONNIE S. WALKERSLEY
R.M.C.

NOTE: 5' DRAINAGE & UTILITY EASEMENT EACH SIDE OF ALL SIDE & REAR LOT LINES.

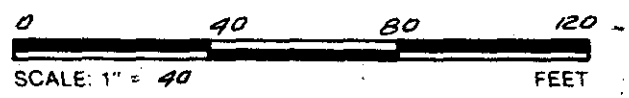

11-Q-67 37504

THIS IS TO CERTIFY THAT THE PROPERTY SHOWN ON THIS PLAT WAS SURVEYED UNDER MY DIRECT SUPERVISION. PROPERTY LINES AND IMPROVEMENTS SHOWN ARE LOCATED CORRECTLY AND THAT NO VISIBLE ENCROACHMENTS EXIST UNLESS OTHERWISE SHOWN. THIS PROPERTY IS NOT LOCATED IN A DESIGNATED FLOOD HAZARD AREA.

3003
31A01



STATE OF SOUTH CAROLINA
GREENVILLE COUNTY

WOODHARBOR
LOT 11
PROPERTY OF
LOUIS E. PEARLE
ANNE T. PEARLE

FREELAND & ASSOCIATES
Engineers • Land Surveyors
318 WEST STONE AVENUE.
GREENVILLE, S.C.
(803) 271-4924

PLAT BOOK	5 P - 37
DEED BOOK	1150 - 380
TAX MAP	538.4 - 1-51
PARTY CHIEF	
DRAWN	B.R.
DATE	5-30-85
DWG. NO.	13/13