MICROFILMED

GREENVILLE CO. S.C.

JUN 12 4 20 PM '85

DONNIE S. TANKERSLEY
R.M.C.

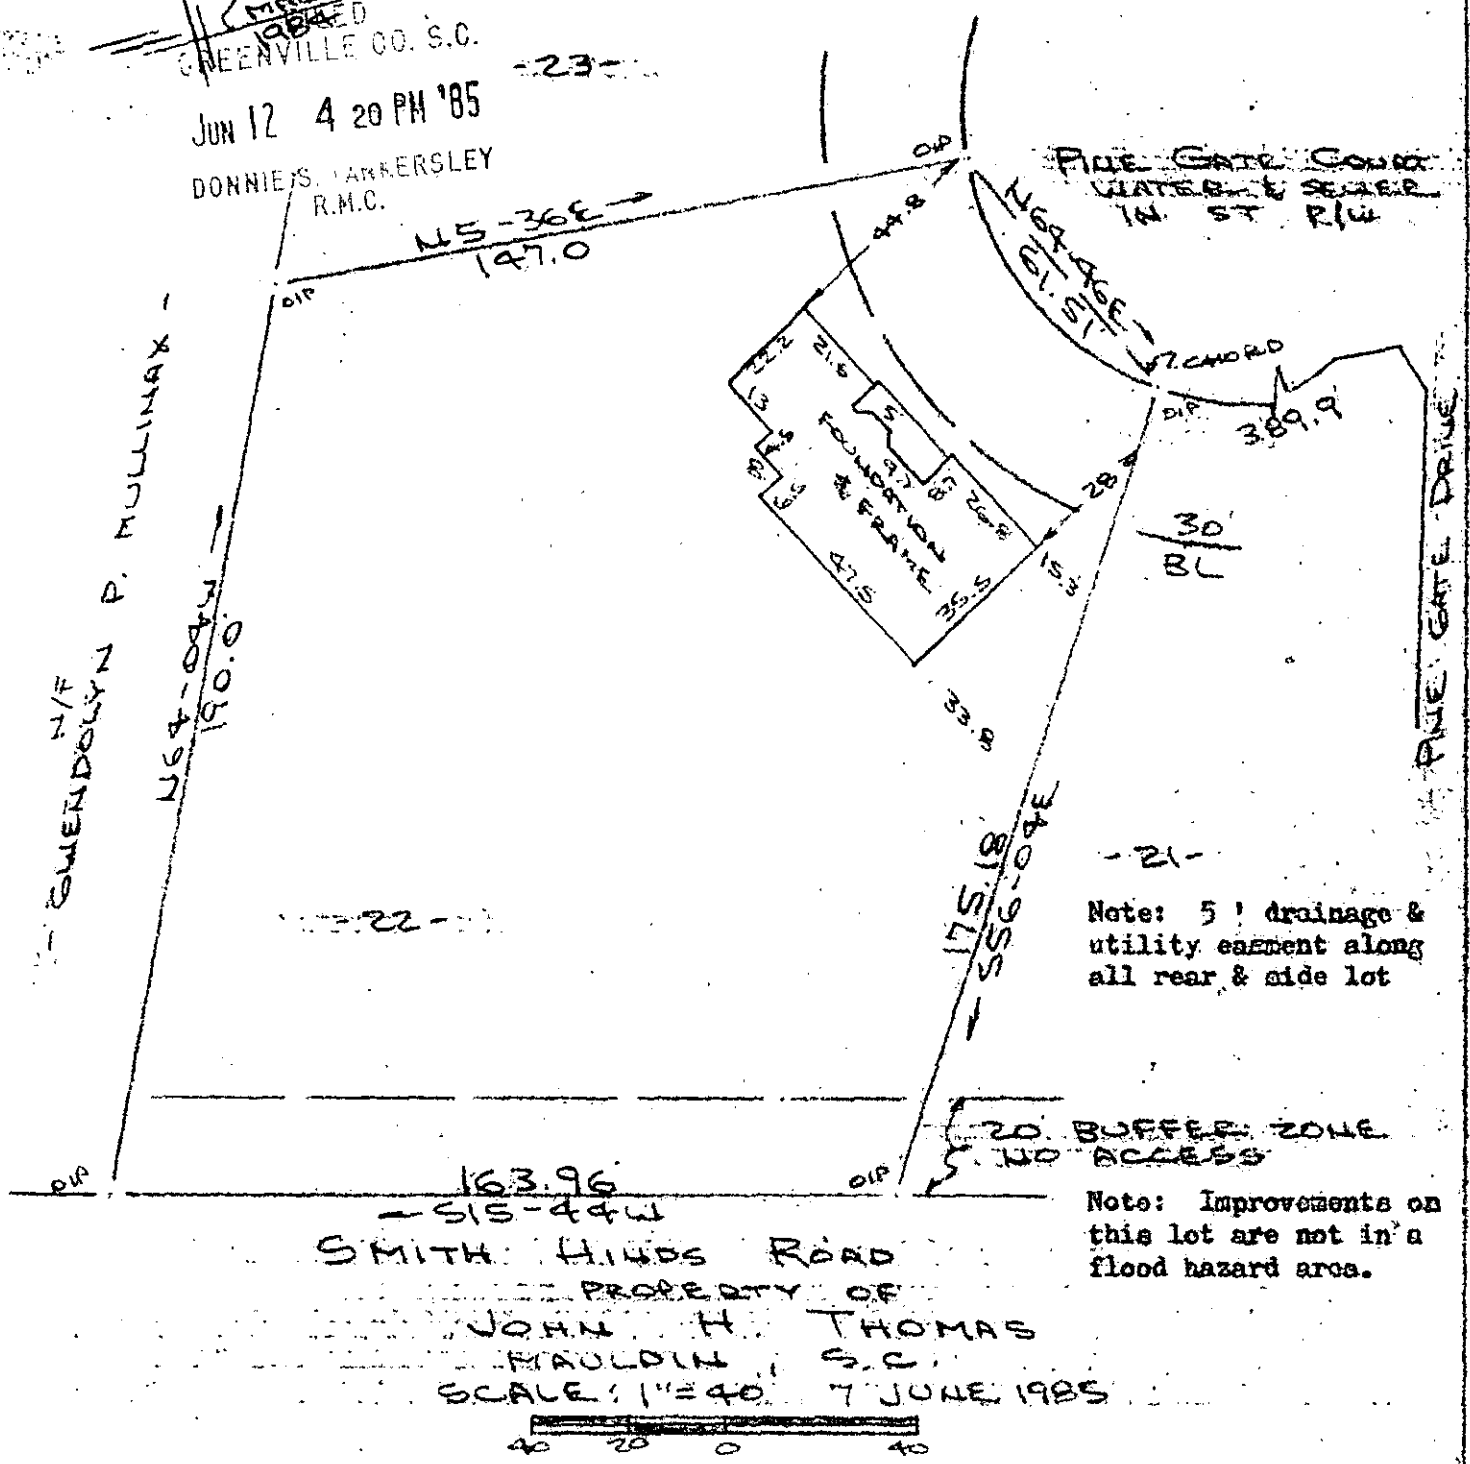

Note: 5 ' drainage & utility easment along all rear & side lot

Note: Improvements on this lot are not in a flood hazard area.

This is to certify that on the 7th day of June, 1985, I surveyed the property shown on this plat, being known as lot 22 on plat of PINE GATE and recorded in the RMC Office Greenville County, S. C., in Plat Book " 10 - M " at Page 70; and that the property lines, walls and buildings are as shown hereon, and that the walls and buildings located on said lot do not encroach or project on adjacent street or property, and that no adjacent walls or buildings encroach or project on said premises, and no power lines cross this property except as shown hereon.

11Q-84 37944

JUN 12 1985

R. B. Bruce, RLS # 1952

CAROLINA SURVEYING CO.
112 Manly St.
Greenville, S. C.

Recordable Plat