


MICROFILMED

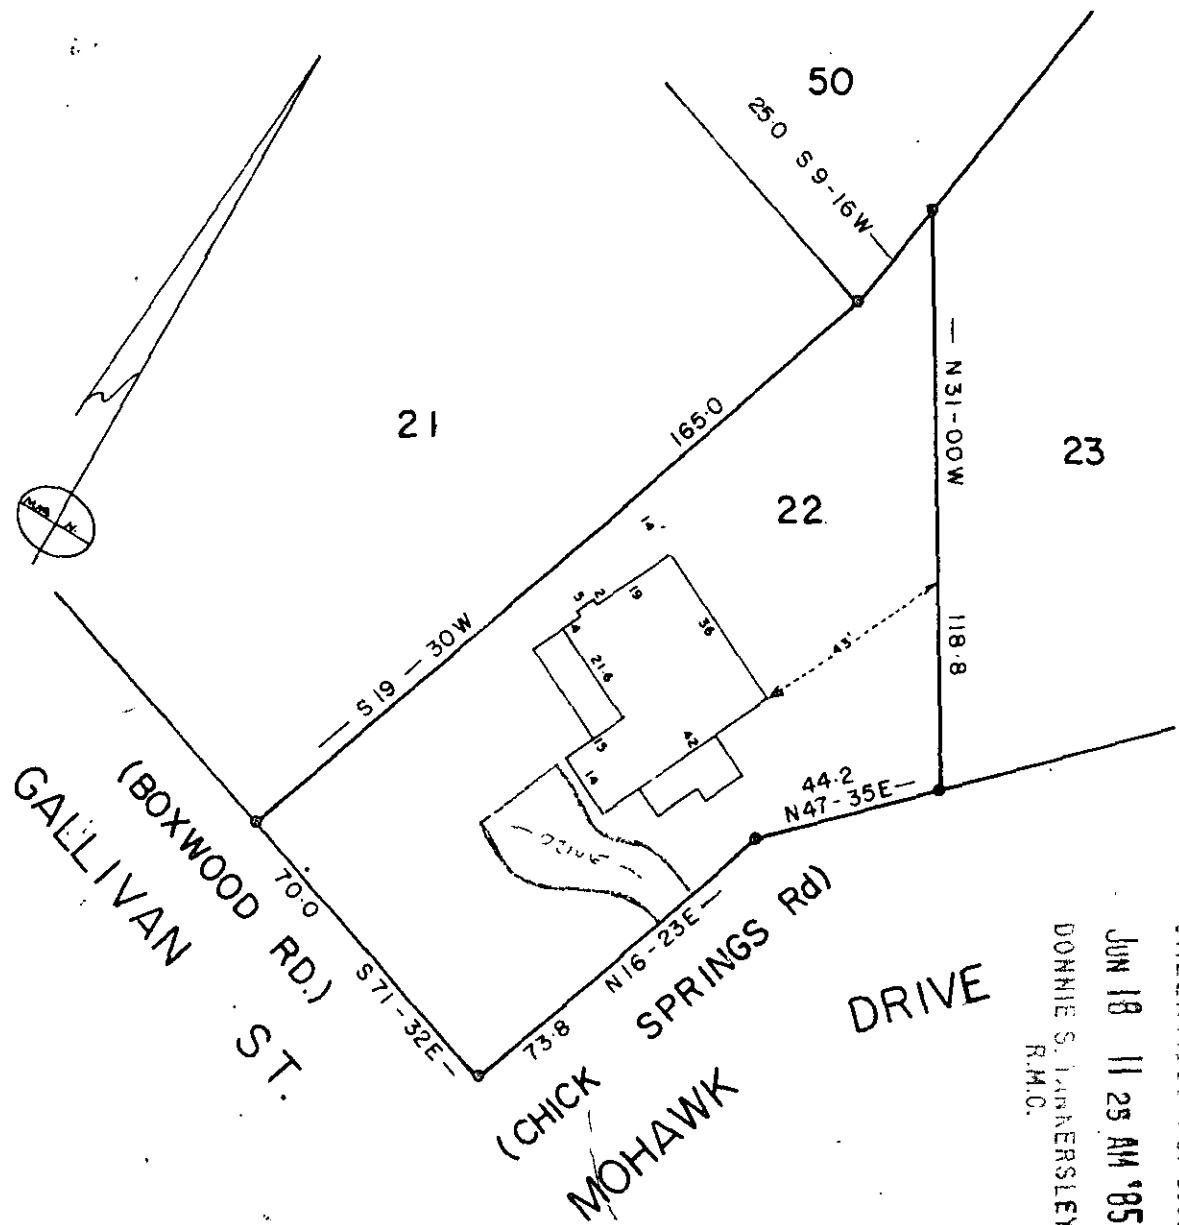

GALLIVAN ST.  
(BOXWOOD RD.)

CHICK SPRINGS Rd  
MOHAWK DRIVE

FILED  
GREENVILLE CO. S.C.  
JUN 18 11 25 AM '85  
DONNIE S. JANKERSLEY  
R.M.C.

JUN 18 1985

NOTE THIS LOT DOES NOT LIE IN A FLOOD PLANE.

11-R-1

38571 ✓

PROPERTY OF



DAVID R. STONE

GREENVILLE, S. C.

This is to certify that on the 15 day of APR,  
1985, I surveyed the property shown on this plat,  
being: LOT 22 NORTHWOOD  
BLK. BK. 187 - 5 - 28

and recorded in Plat Book J, page 02-103 of the R.M.C.  
Office for GREENVILLE County, S. C.

and that the property lines, walls  
and buildings are as shown hereon;  
that the buildings located on said  
lot do not encroach or project on  
adjacent streets or property; and  
that no adjacent buildings or walls  
encroach or project on said premises,  
and that no utility lines cross this  
property unless shown on plat.

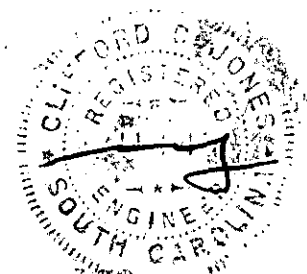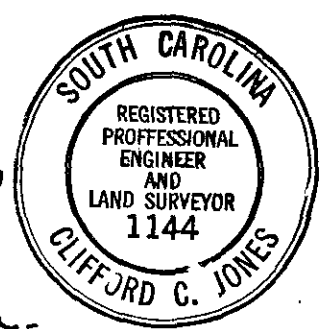

APR 15 - 1985 SCALE 1"=40'

