


MICROFILM

MAG. NORTH

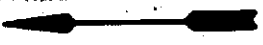

5' R/W FOR SEWER LINE

25' SAN. SEWER EASEMENT

GERALDINE P. CRAIN

LOT 2

GERALDINE P. CRAIN

LOT 1


FILED GREENVILLE CO. S.C. JUN 18 1 31 PM '85 DONNIE S. HERSLEY R.M.C.

S 76° 51' E 289.23

S 54° 49' W 55.45

S 88° 08' W 229.24

HOUSE UNDER CONST.

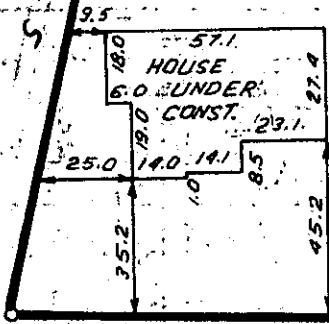

727.66 ± TO JULIAN ROAD


N 0° 30' E 111.00

38570

PHILLIPS LANE

JUN 18 1985

11R-3

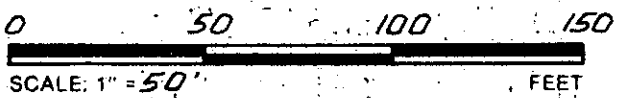

THIS IS TO CERTIFY THAT THE PROPERTY SHOWN ON THIS PLAT WAS SURVEYED UNDER MY DIRECT SUPERVISION. PROPERTY LINES AND IMPROVEMENTS SHOWN ARE LOCATED CORRECTLY AND THAT NO VISIBLE ENCROACHMENTS EXIST UNLESS OTHERWISE SHOWN. THIS PROPERTY IS NOT LOCATED IN A DESIGNATED FLOOD HAZARD AREA

SOUTH CAROLINA REGISTERED LAND SURVEYOR
 4781
JAMES R. FREELAND
 R/S: JAMES R. FREELAND
 NO. 4781

STATE OF SOUTH CAROLINA GREENVILLE COUNTY

PROPERTY OF
M.W. BROCK D.B.A.
BROCK CONSTRUCTION

FREELAND & ASSOCIATES
 Engineers • Land Surveyors
 318 WEST STONE AVENUE
 GREENVILLE, S.C.
 (803) 271-4924

| | |
|-------------|---------|
| PLAT BOOK | |
| DEED BOOK | |
| TAX MAP | |
| PARTY CHIEF | G.P. |
| DRAWN | J.R. |
| DATE | 6-13-85 |
| DWG. NO. | 13217 |