MICROFILMED

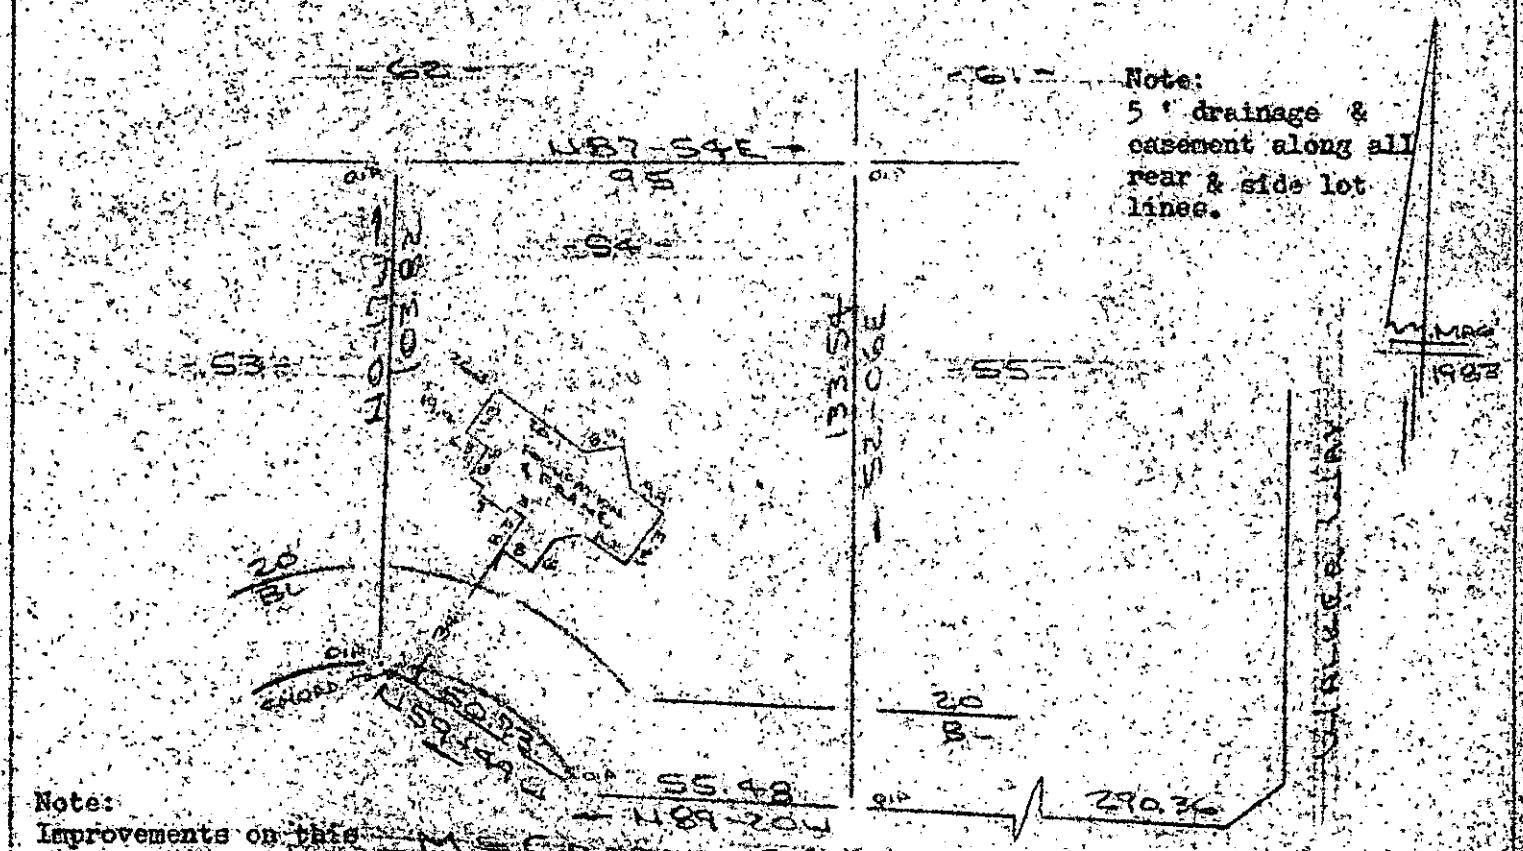

Note:
5 ' drainage & easement along all rear & side lot lines.

Note:
Improvements on this lot are not in a flood hazard area.

PROPERTY OF
DAVID G. SMITH & KAY C. SMITH
NEAR GREENVILLE, S.C.
SCALE: 1"=40' 30 APR 1985

This is to certify that on the 30th day of April, 1985, I surveyed the property shown on this plat, being known as lot 54 on plat of WALKERS CROSSING and recorded in the RMC Office Greenville County, S. C., in Plat Book " 10 - M " at Page 2; and that the property lines, walls and buildings are as shown hereon, and that the walls and buildings located on said lot do not encroach or project on adjacent street or property, and that no adjacent walls or buildings encroach or project on said premises, and no power lines cross this property except as shown hereon.

38862

11-R-18

JUN 20 1985

R. B. Bruce

R. B. Bruce, RLS # 1952

Recordable Plat

CAROLINA SURVEYING CO.
112 Manly St.
Greenville, S. C.

300 8 21801

289/224