


FILED
 GREENVILLE CO. S.C.
 JUNE 21 3 11 PM '85
 DONNIE S. WALKERSLEY
 R.M.C.

16

17

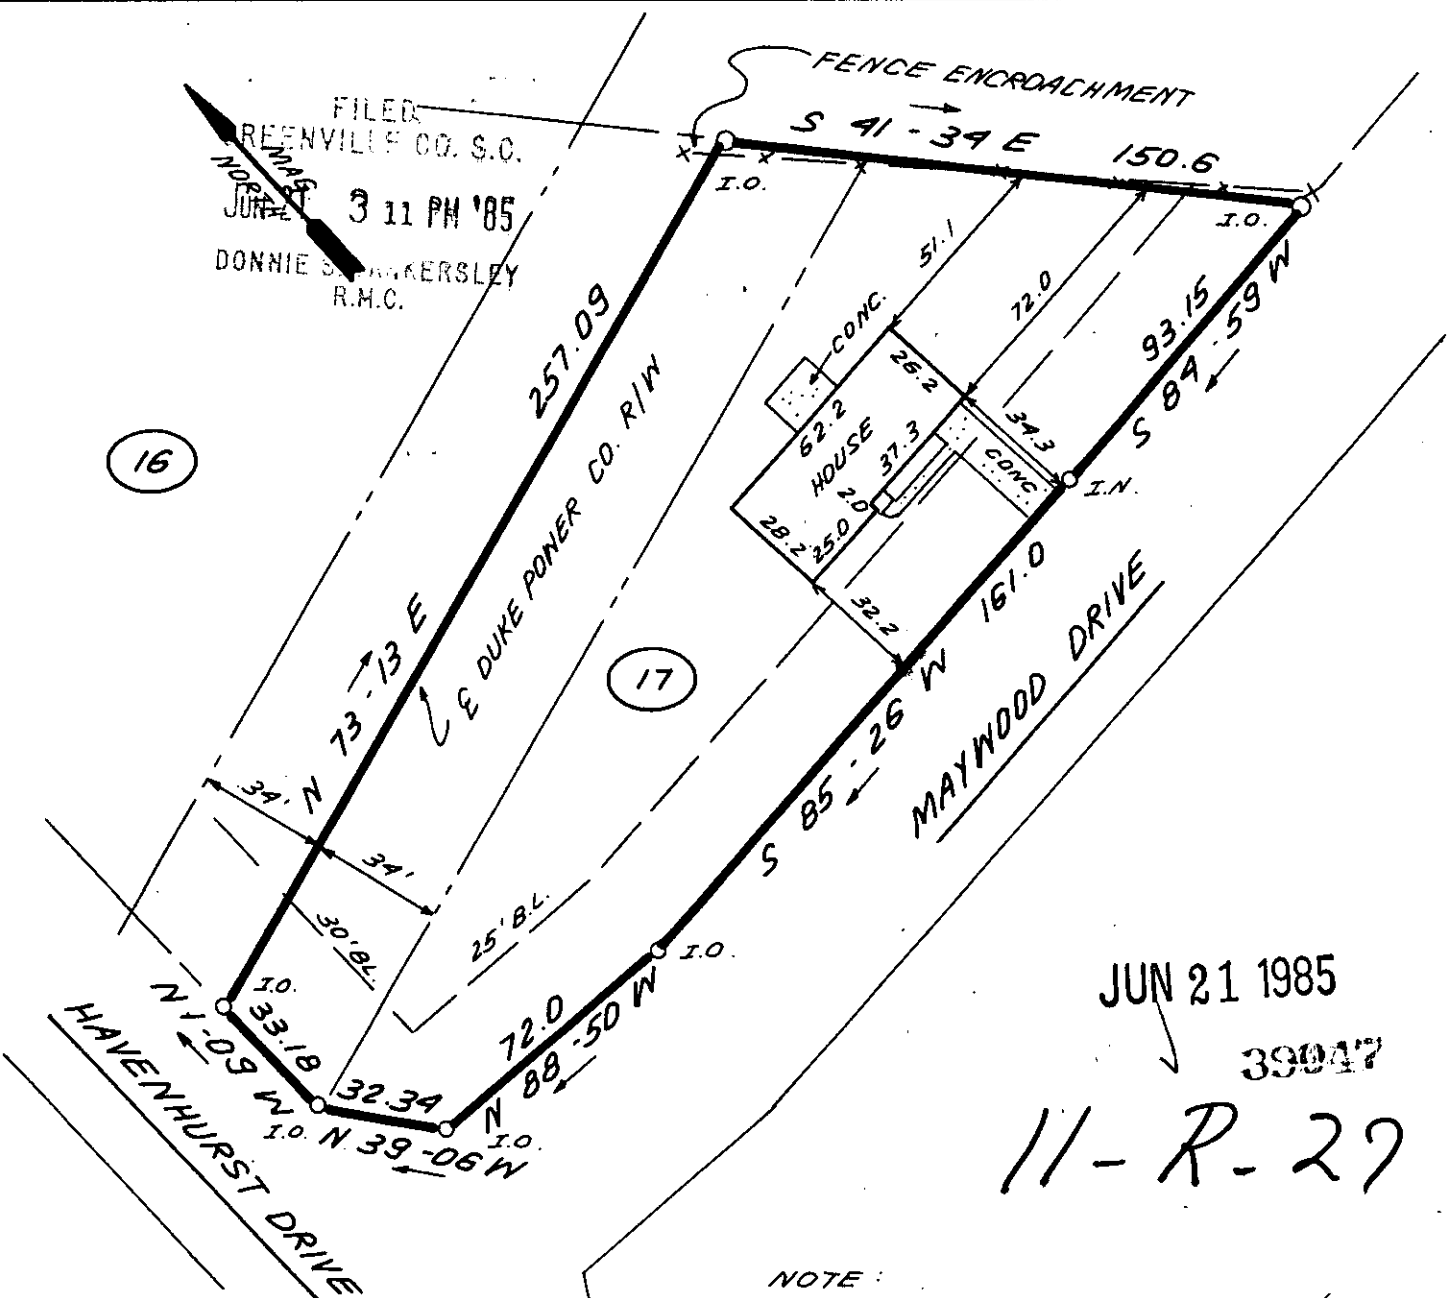


JUN 21 1985
 39047

11-R-27

NOTE:
 THERE IS A 5' DRAINAGE &
 UTILITY EASEMENT EACH SIDE
 ALL SIDE & REAR LOT LINES.

THIS IS TO CERTIFY THAT THE PROPERTY SHOWN ON THIS PLAT WAS SURVEYED UNDER MY DIRECT SUPERVISION. PROPERTY LINES AND IMPROVEMENTS SHOWN ARE LOCATED CORRECTLY AND THAT NO VISIBLE ENCROACHMENTS EXIST UNLESS OTHERWISE SHOWN. THIS PROPERTY IS NOT LOCATED IN A DESIGNATED FLOOD HAZARD AREA.

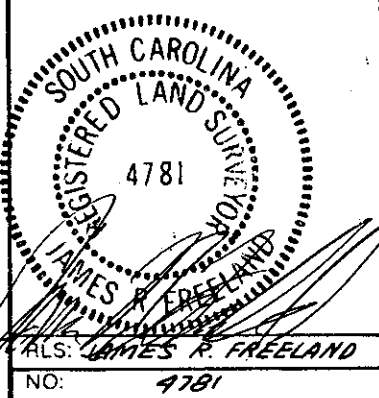

**STATE OF SOUTH CAROLINA
 GREENVILLE COUNTY**

FREELAND & ASSOCIATES
 Engineers • Land Surveyors
 318 WEST STONE AVENUE,
 GREENVILLE, S.C.
 (803) 271-4924

HOMESTEAD ACRES
LOT 17
PROPERTY OF
EDWARD E. TIMBLIN
JANELL G. TIMBLIN

PLAT BOOK	6H @ 77
DEED BOOK	
TAX MAP	P16-1-1-932
PARTY CHIEF	R.A.J.
DRAWN	K.E.G.
DATE	6-19-85
DWG. NO.	13252