MICROFILMED

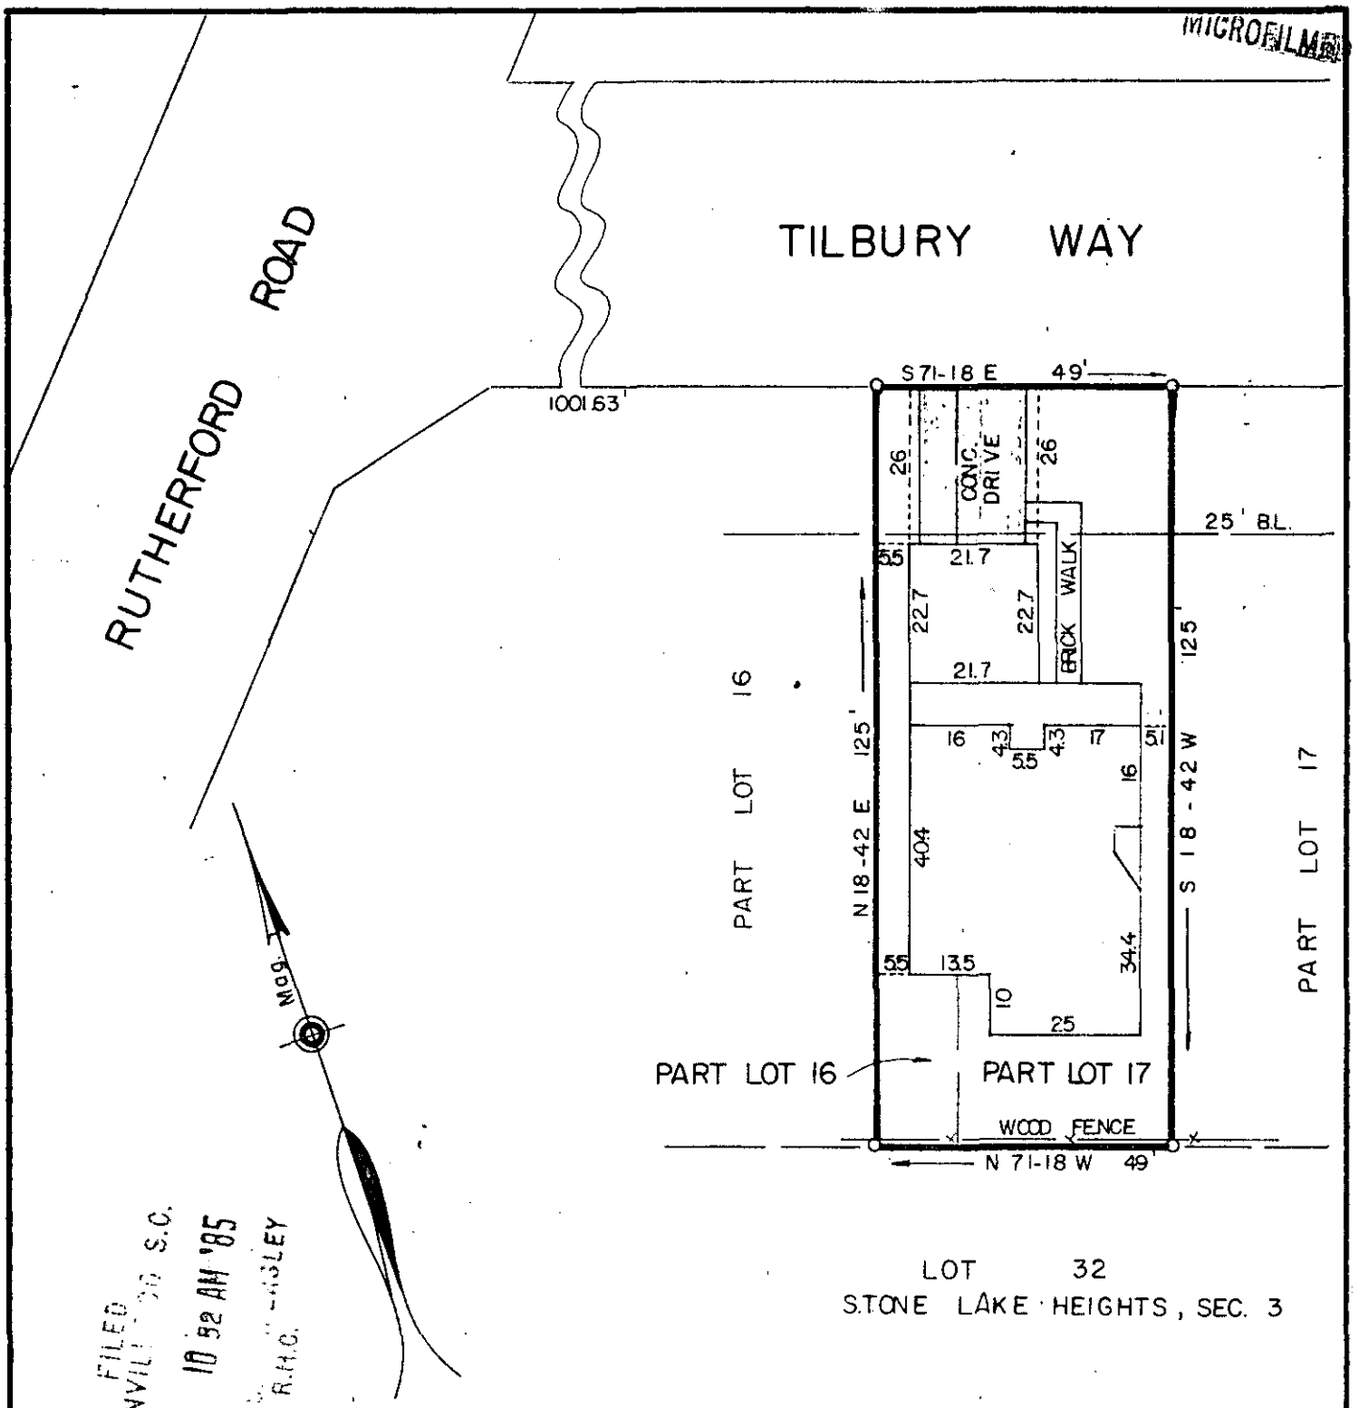

LOT 32
STONE LAKE HEIGHTS, SEC. 3

FILED
GREENVILLE CO. S.C.
JUN 25 10 32 AM '85
DONNIE S. TANKERSLEY
R.M.C.

PROPERTY OF

THE SMITH COMPANIES
A GENERAL PARTNERSHIP

GREENVILLE COUNTY, S.C.

Scale 1" = 30' June, 1985

JUN 25 1985

39307 ✓ 11-R-36

This is to certify that on the 17th day of June, 1985, we surveyed the property shown on this plat being known as Part Lot 17 & Part Lot 16 on Stone Glen, recorded in plat book 9-W, page 46, Office of R.M.C., Greenville County, S.C.; and that the property lines, walls and buildings are as shown hereon; that the buildings located on said lot do not encroach or project on adjacent streets or property; and that no adjacent buildings or walls encroach or project on said premises; and from information frmm Greenville County, this structure is not located in a designated flood area.

R. W. Dalton

DALTON & NEVES CO., INC. ENGINEERS

F. B. 495

S. C. Reg. No. 916