


MAY 1985


ROBERT HEAD

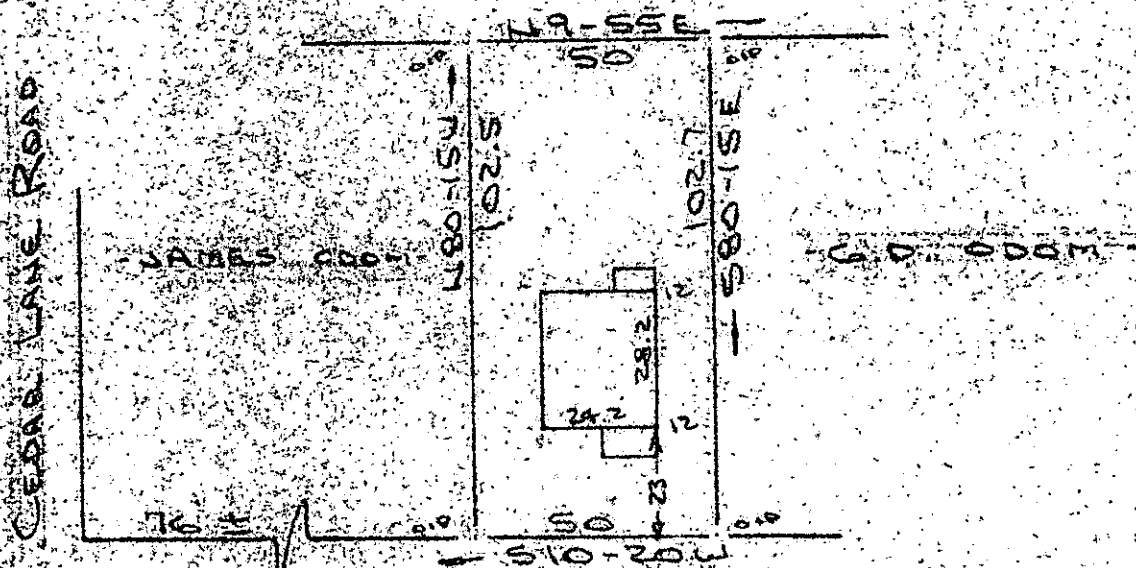

Note: Improvements on this lot are not in a flood hazard area.

FINLEY STREET (GREEN STREET)
WATER & SEWER IN ST R/W

PROPERTY OF
B. ROBERT COKER, JR.
NEAR GREENVILLE, S.C.
SCALE 1" = 40' 11 JUNE 1985

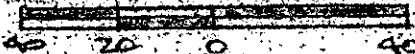

This is to certify that on the 11th day of June, 1985, I surveyed the property shown on this plat, being known as lot on plat of PROPERTY OF MAY H. HARGROVE and recorded in the RMC Office Greenville County, S. C., in Plat Book "U" at Page 195 and also known as PROPERTY OF B. ROBERT COKER, JR. and recorded in the RMC Office Greenville County, S. C., in Plat Book _____ at Page _____ and that the property lines, walls and buildings are as shown hereon, and that the walls and buildings located on said lot do not encroach or project on adjacent street or property, and that no adjacent walls or buildings encroach or project on said premises, and no power lines cross this property except as shown hereon.

39626

11-R.52

JUN 27 1985

R. B. Bruce

R. B. Bruce, RLS # 1952

Recordable Plat

CO.

FILED
RENEWVILLE CO., S.C.
JUN 27 10 56 AM '85
DONNIE S. HANFORD
R.M.C.

CAROLINA SURVEYING
112 Manly St.
Greenville, S. C.

